


T.3 S. R. 3E.W.M.

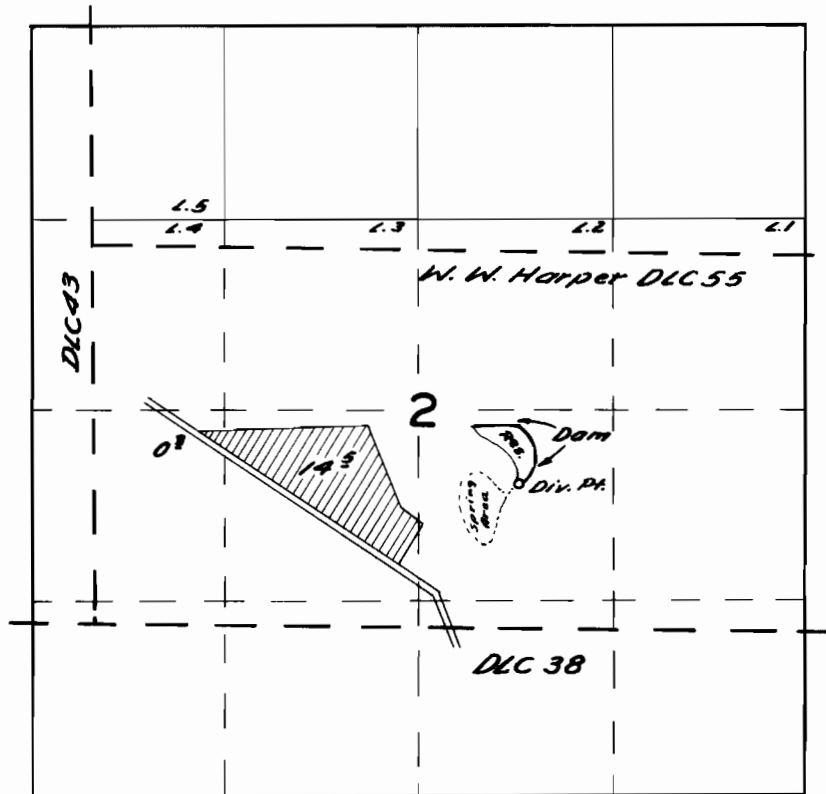

FINAL PROOF SURVEY

UNDER

Application No. ^{R-26986} ~~26987~~ Permit No. ^{R-1344} ~~21197~~
IN NAME OF

H. W. McFadden

Surveyed Sept. 26 1956, by C. O. Bartels