


T. T. S. R. I. E. W. W.

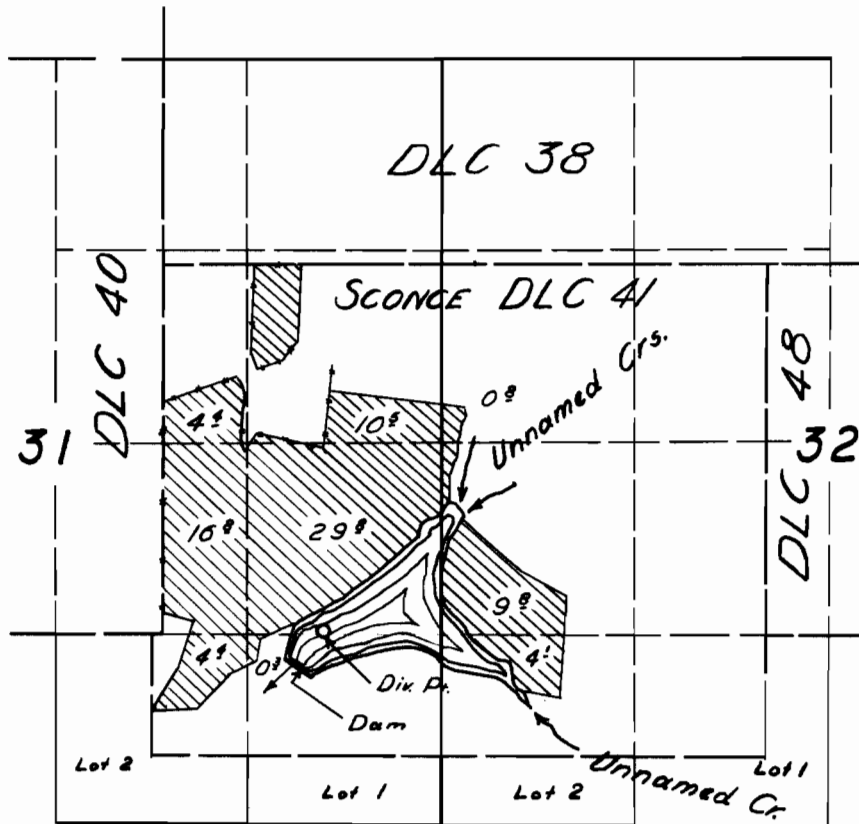

FINAL PROOF SURVEY

UNDER

24607

21232

Application No. R-24606 Permit No. R-1348

IN NAME OF

FLOYD T. FOX

Surveyed 29 May 1956, by [Signature]