


T.4 S. R. 5 W. W.M.

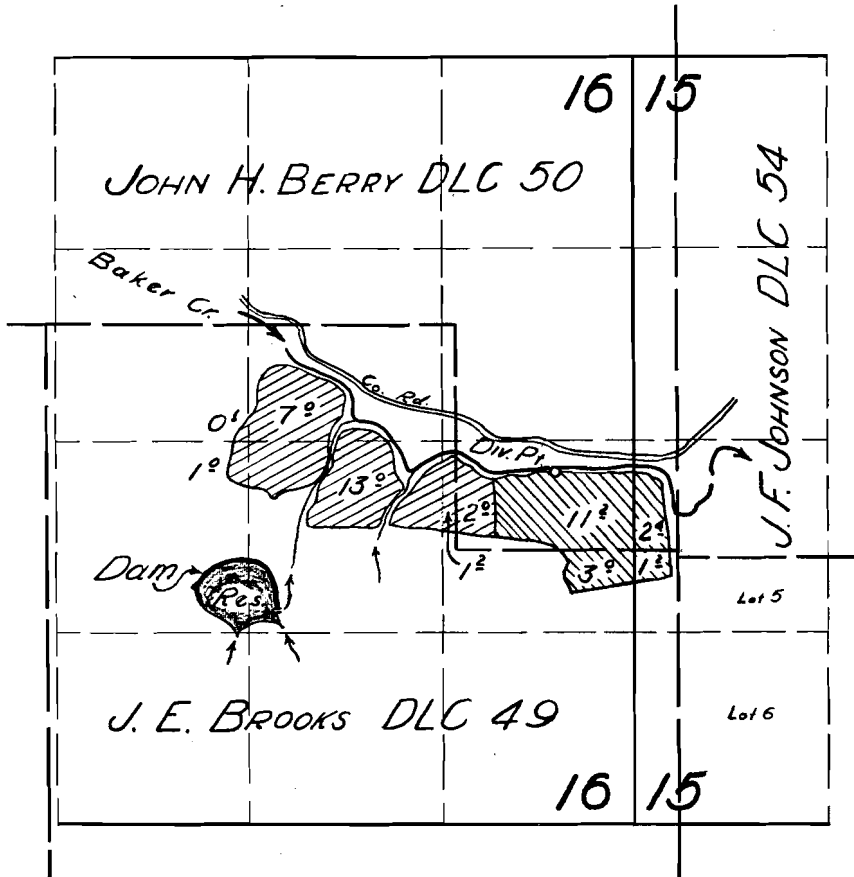

**FINAL PROOF SURVEY**

25085

R-27295

Application No. 27296

IN NAME OF

**D. MOCHETTAZ**

Surveyed 19 Mar 1956, by

*C. H. White*

19746

R-1411

Permit No. 21669

