


T.4S.R.5W.W.M.

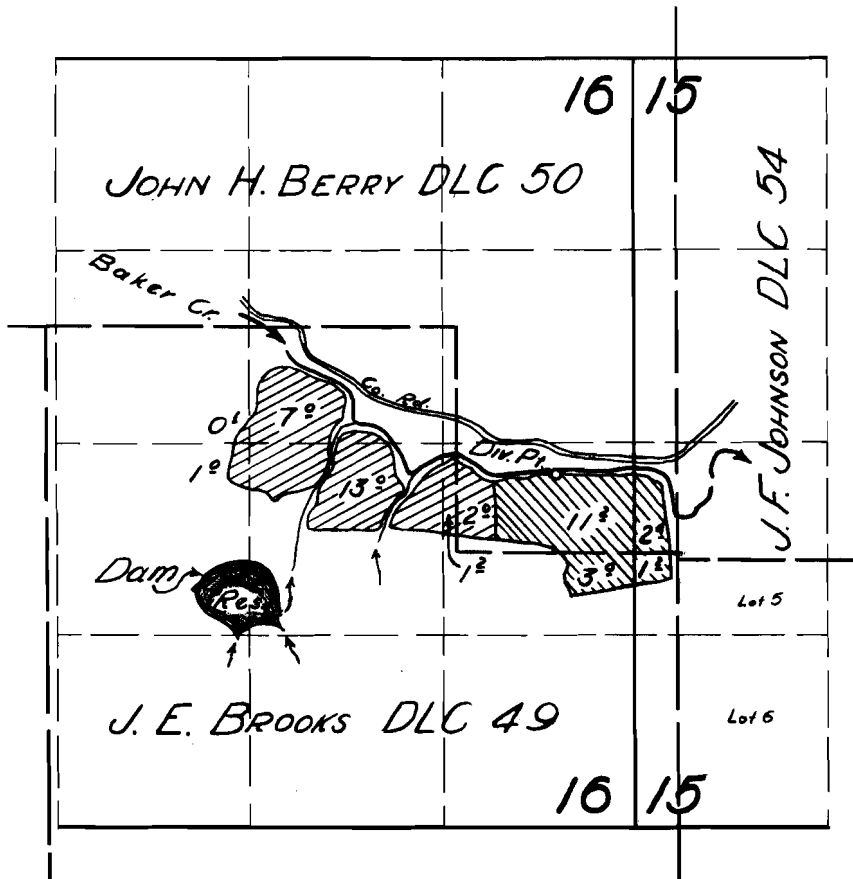

FINAL PROOF SURVEY

25085

19746



R-27295

R-1411

Application No. 27296

Permit No. 21669



IN NAME OF

D. MOCHETTAZ

Surveyed 19 Mar 1956, by