


T. 4S. R. 1E. W.M.

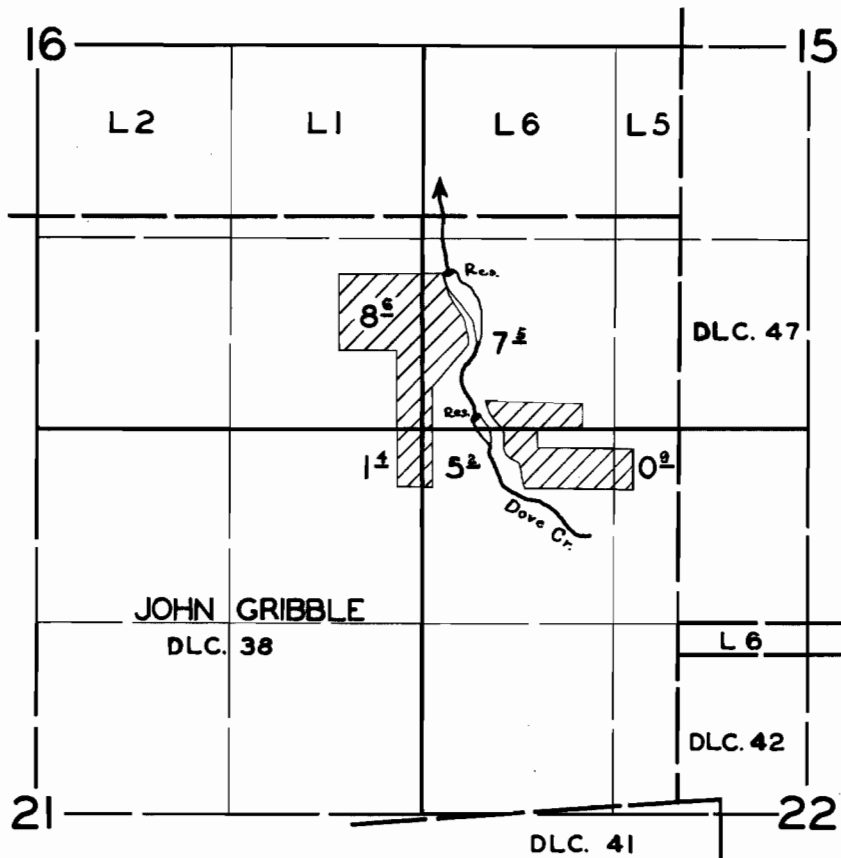

FINAL PROOF SURVEY

UNDER

R-27654

R-1432

Application No. ~~27655~~ Permit No. ~~21780~~

IN NAME OF

HOWARD J. & CHESTER H. SMITH

Surveyed 9.MAR. 1956, by R.D.BEST