


T. 5S. R. 3E. WM.

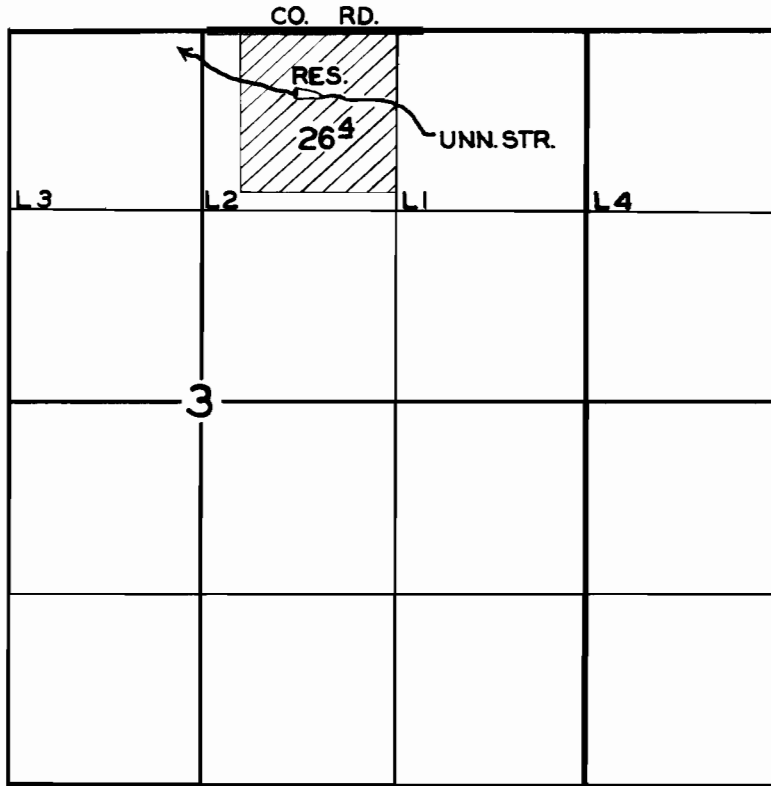

**FINAL PROOF SURVEY**

UNDER

**R-23596**

**R- 975**

Application No. **23597** Permit No. **10003**

IN NAME OF

**CARL A. SWANSON**

Surveyed **29 MAR. 1956**, by **R.D. BEST**