


T. 5S. R. 3E. WM.

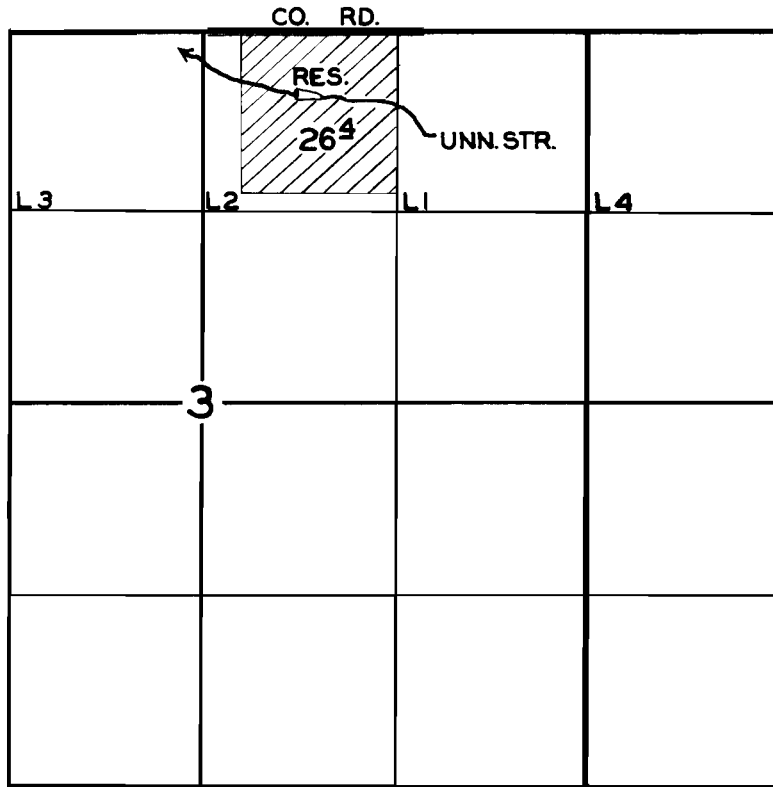

FINAL PROOF SURVEY

UNDER

R-23596

R- 975

Application No. **23597** Permit No. **18803**

IN NAME OF

CARL A. SWANSON

Surveyed **29 MAR. 1956**, by **R.D. BEST**