


T 5 S. R. 5 W. W. M.

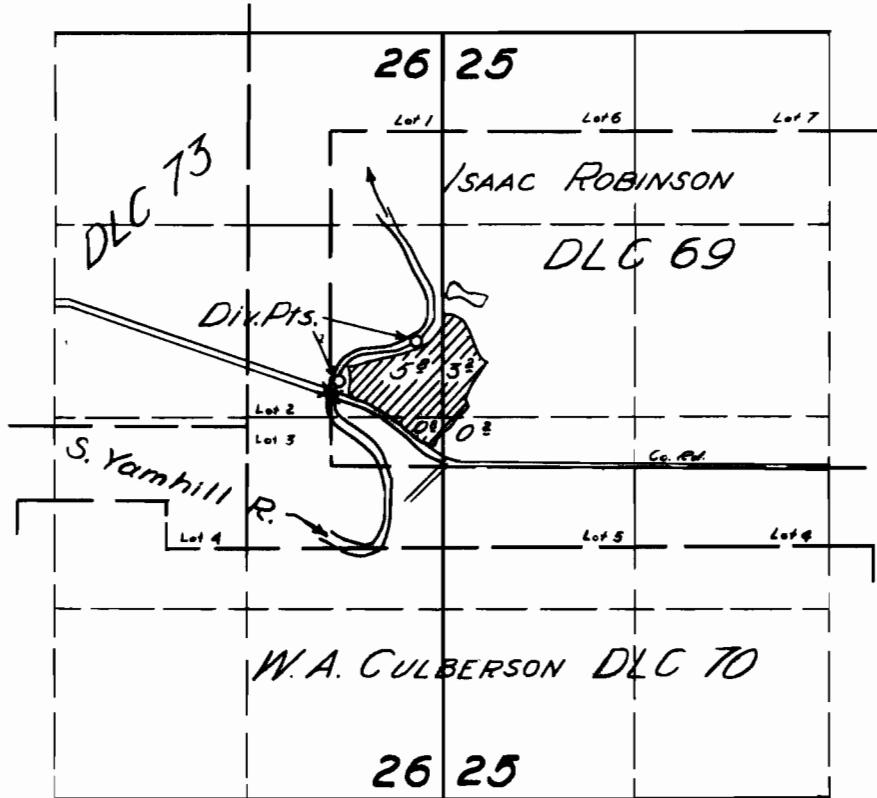

**FINAL PROOF SURVEY**

UNDER

Application No. 17786 Permit No. 13467

IN NAME OF

**GRANT W. DAY**

Surveyed 17 Aug 1956, by *C. P. White*