


T.5S.R.5W.W.M.

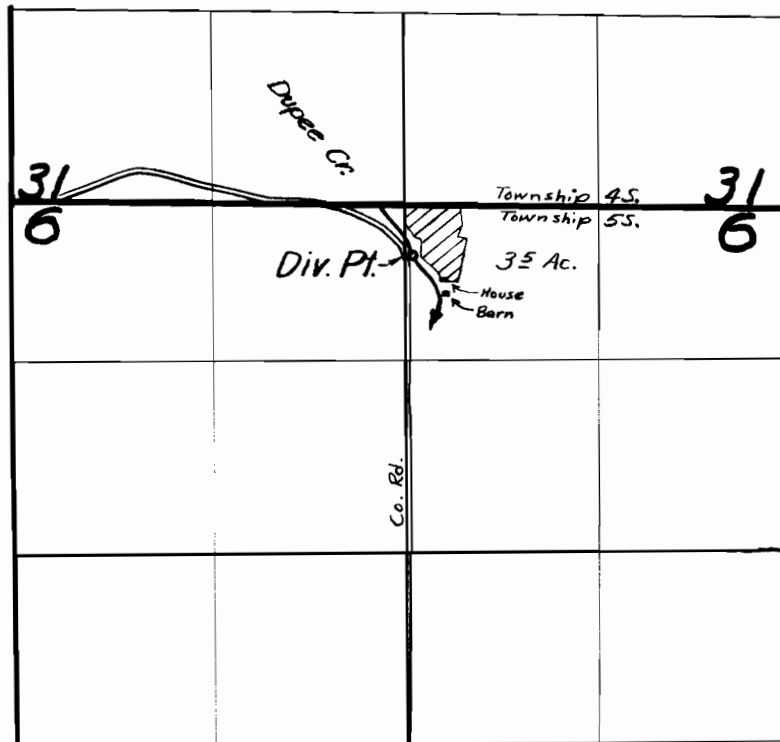

FINAL PROOF SURVEY
UNDER

Application No. *19108* Permit No. *14713*
IN NAME OF

Alvin H. & Helen Rae Smith

Surveyed *Mar 9* 1956, by *Tr. Bush*