


T. 6 S. R. 1 W. W. M.

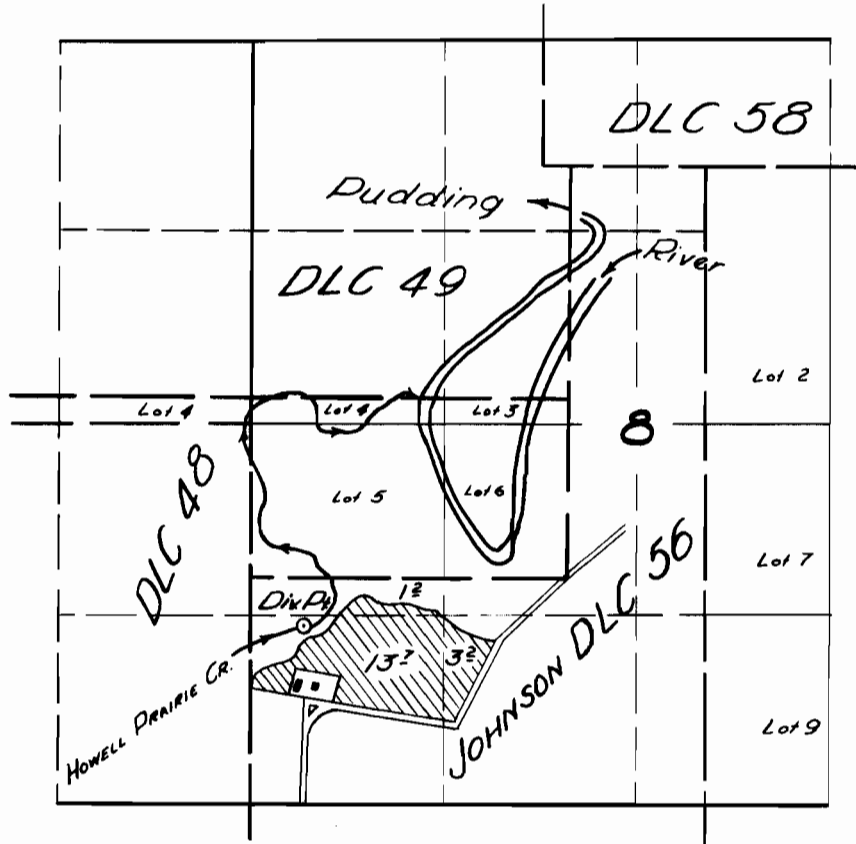

FINAL PROOF SURVEY

UNDER

Application No. 19417 Permit No. 14966

IN NAME OF

L. E. JAHN

Surveyed 30 Mar. 1956, by [Signature]