


T. 8S. R. 46E. W.M.

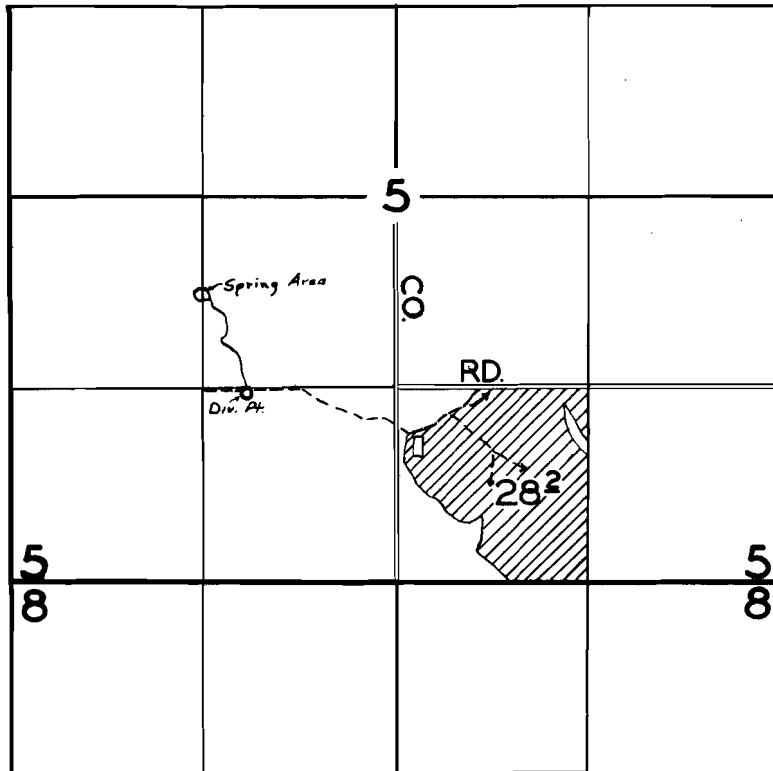

FINAL PROOF SURVEY
UNDER

Application No. 19309 Permit No. 15009
IN NAME OF

VERNON K. YOWELL

Surveyed 13 Oct. 1956, by M. Bish.

BBB-9N-113

PLW5