


MAP DRAWN IN ERROR — SHOULD BE
CORRECTED TO FIT MAP FOR A-33001

T. 4 S. R. 4 W. W. M.

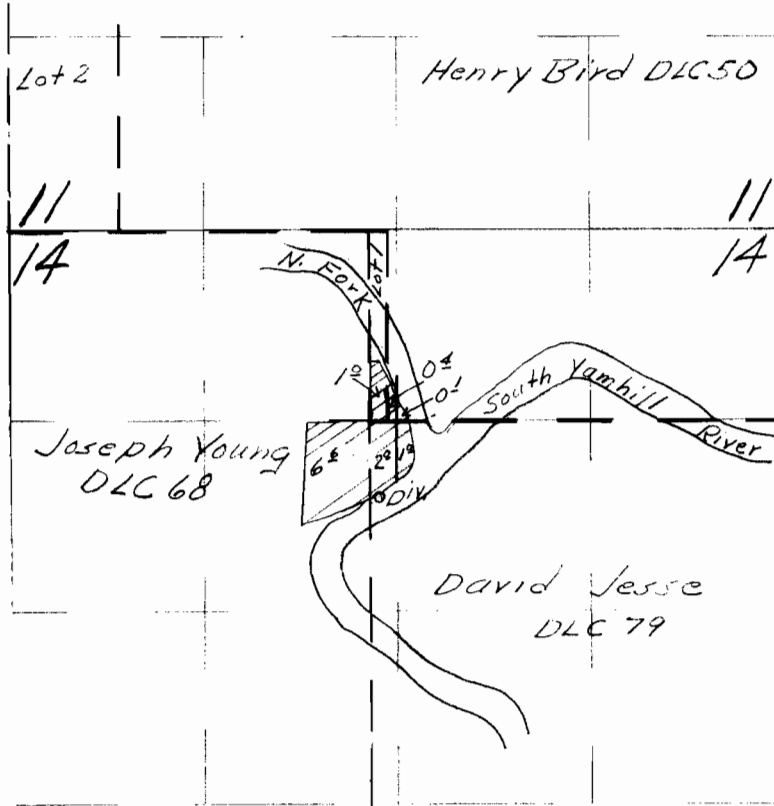

FINAL PROOF SURVEY
UNDER

Application No. 19885 Permit No. 15456
IN NAME OF

H. J. & Bertha Roedel

Surveyed June 9 1955, by T. Jones