


T.10S.R.10W.W.M.

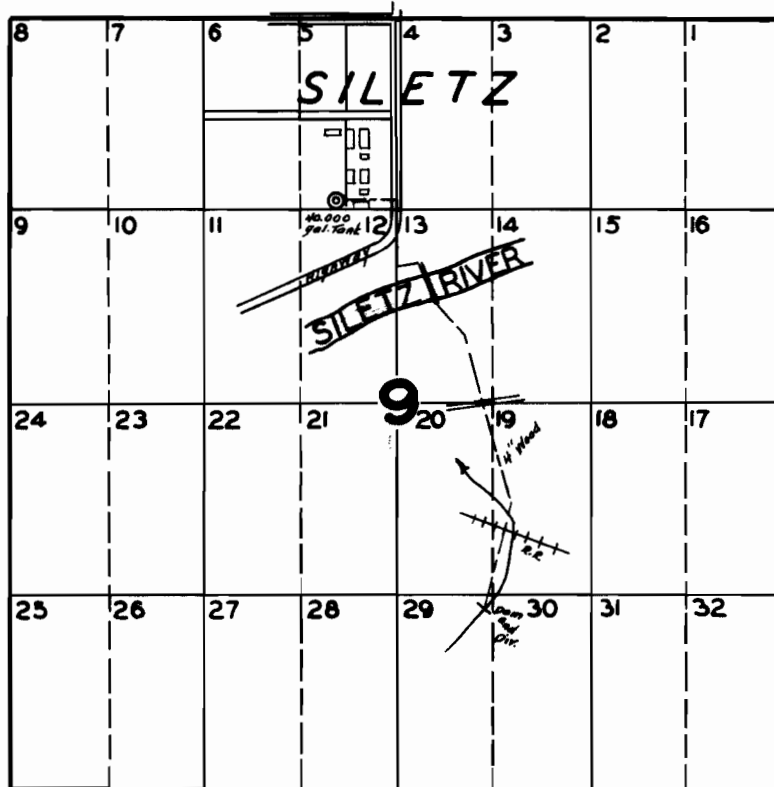

FINAL PROOF SURVEY
UNDER

Application No. 20172 Permit No. 15718

IN NAME OF

CENTRAL LINCOLN PEOPLES UTILITY DISTRICT

Surveyed AUG. 22 1945, by *[Signature]*