


T. 5S. R. 2E. WM.

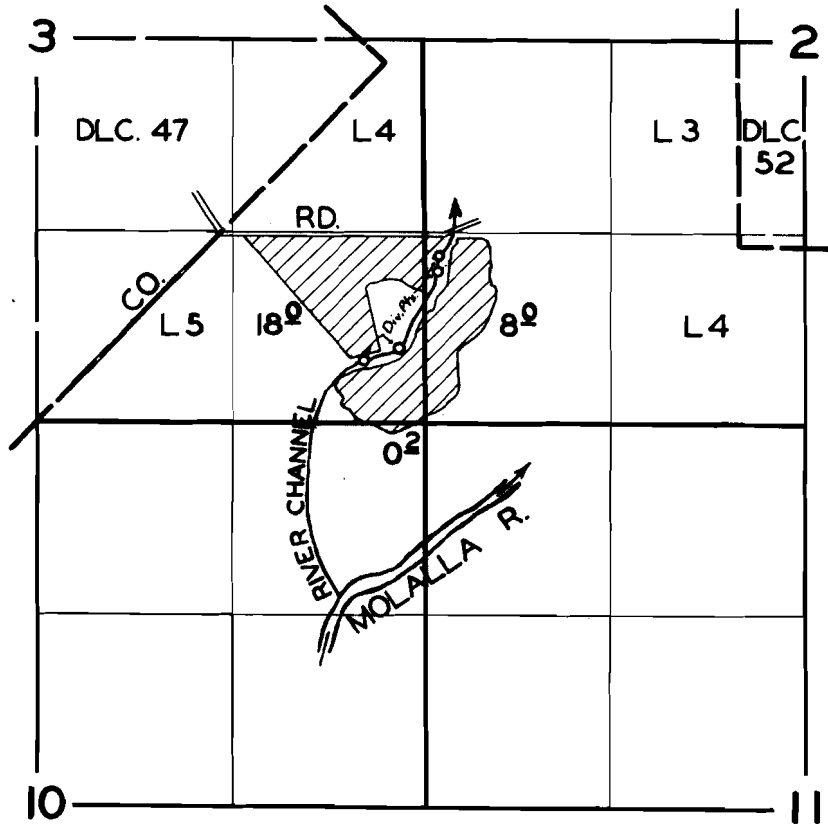

FINAL PROOF SURVEY

UNDER

Application No. 20623 Permit No. 16108
IN NAME OF

ARTHUR B. & RUTH A. KAYSER

Surveyed 13 MAR. 1956, by R. D. BEST