


T.4S. R.IW.W.M.

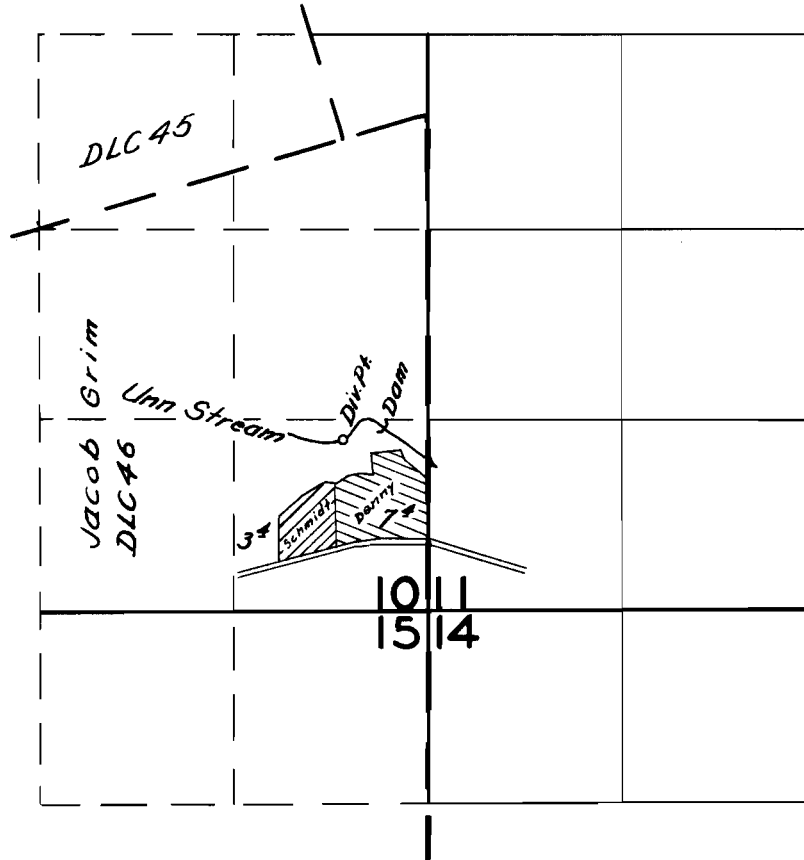

FINAL PROOF SURVEY

UNDER

Application No. *20668* Permit No. *16212*...

IN NAME OF

Wilbur Denny & Otto R. & Esther E. Schmidt

Surveyed *June 1*... 19*56*, by *C. O. Bartels*.