


T. 7N. R. 4W. W.M.

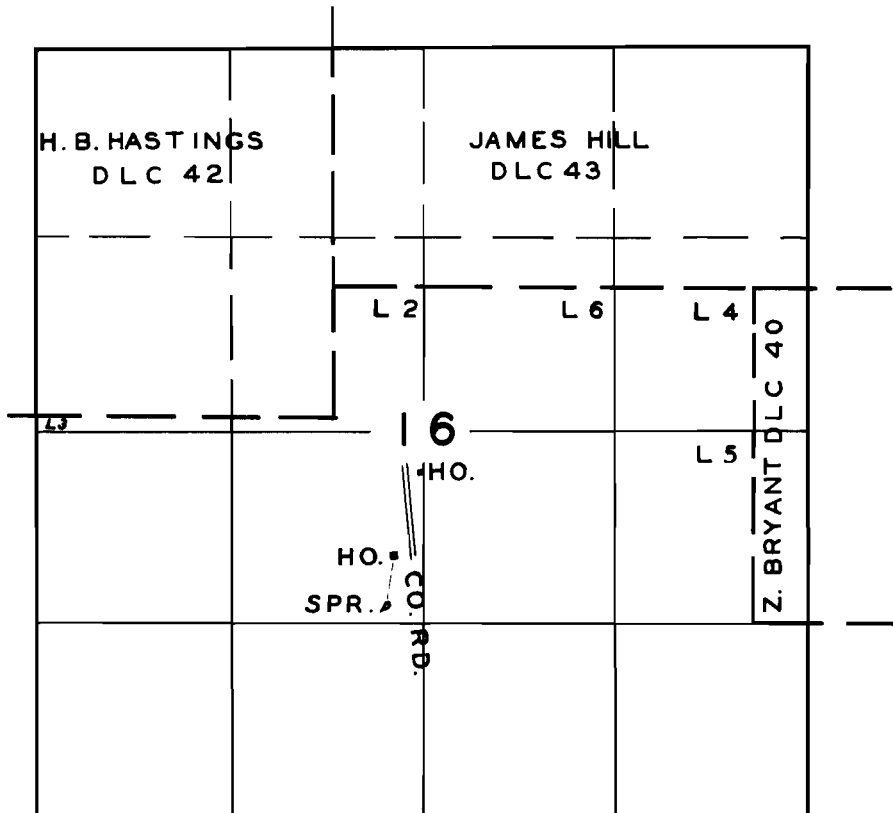

FINAL PROOF SURVEY
UNDER

Application No. 20763..... Permit No. 16248..
IN NAME OF

HARRY M. SAXTON

Surveyed AUG 29 1956, by R. H. WHITBY...