


T. 4S. R. 2E. WM.

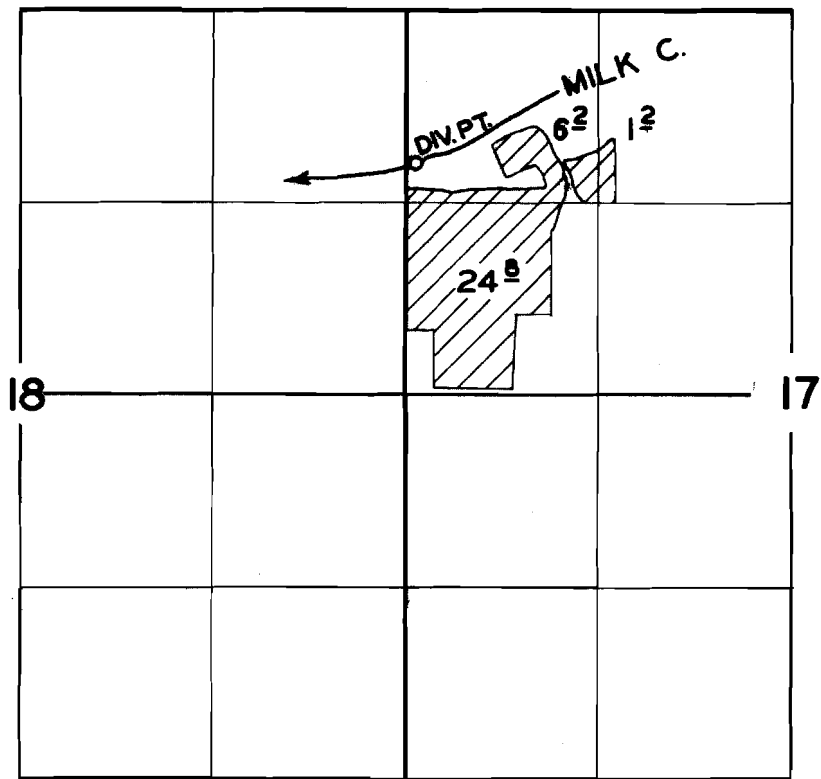

**FINAL PROOF SURVEY**

UNDER

Application No. 21328 Permit No. 16724

IN NAME OF

RAYMOND M. & JOSEPHINE E. JOHNSON

Surveyed 12.MAR. 1956., by R.D. BEST.....

DFK-3D-121

RWB