


T.2 S. R. 5 W. W. M.

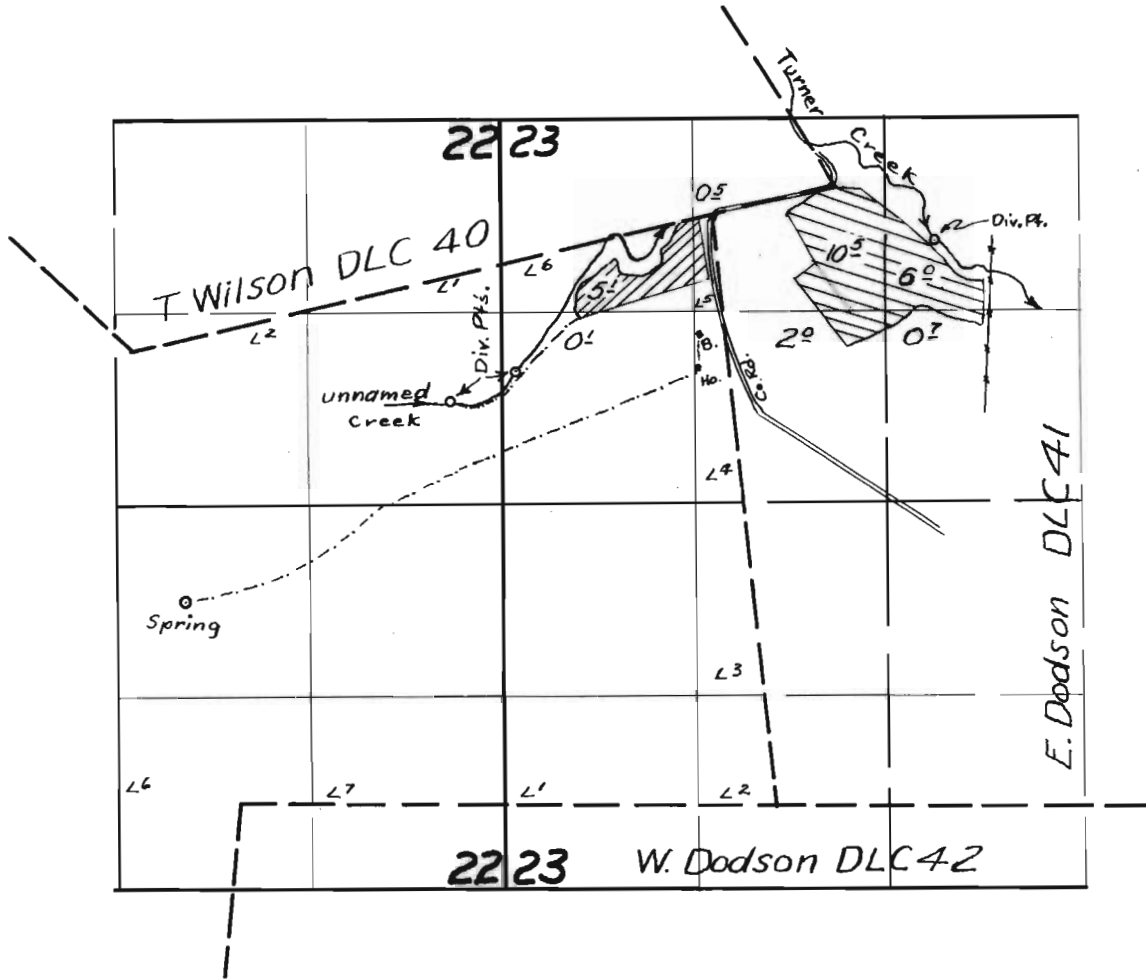

FINAL PROOF SURVEY
UNDER

Application No. 21534 Permit No. 16935
IN NAME OF

L. J. Simonsen

Surveyed 4 April 1956, by T. M. Bisha