


T. 14S, R. 14E, W. 1M.

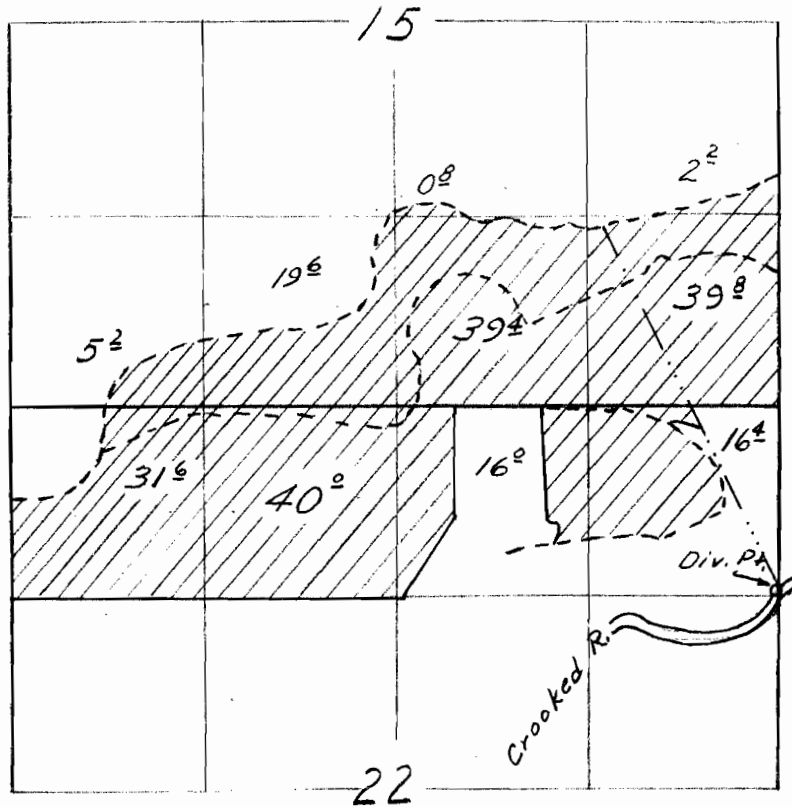

Final Proof Survey  
Under

Application No. 21823 Permit No. 17167  
In Name Of

Claude Butler

Surveyed April 23, 1955 by T. Jones