


T. IS. R. 415E. W.M.

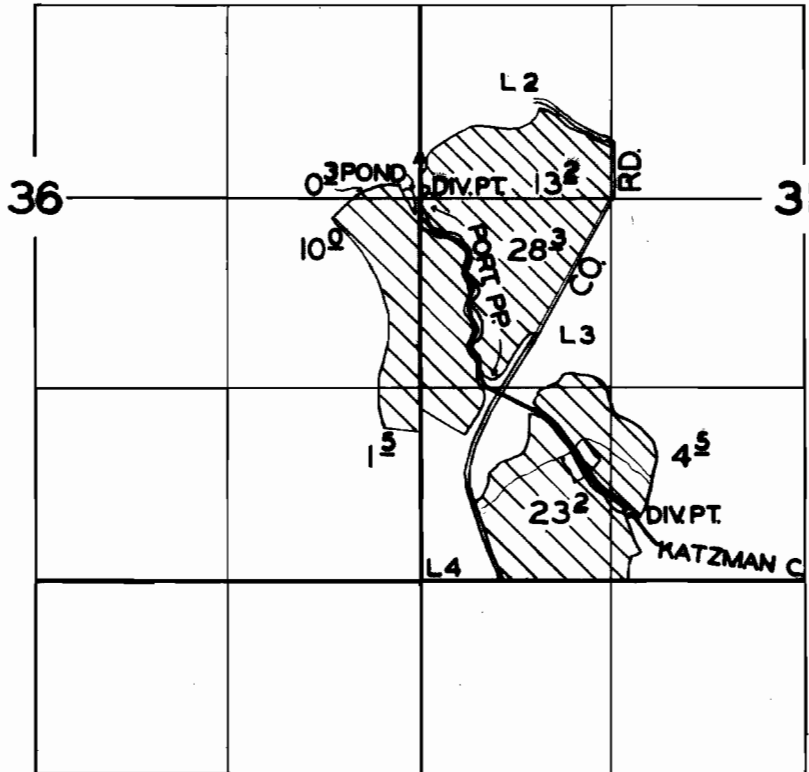

FINAL PROOF SURVEY

UNDER

Application No. 21983 Permit No. 17288

IN NAME OF

A. H. HORNING

Surveyed 11 JUNE 1956, by R. D. BEST

DFK-4D-76

Best