


T.6S. R.1W.W.M.

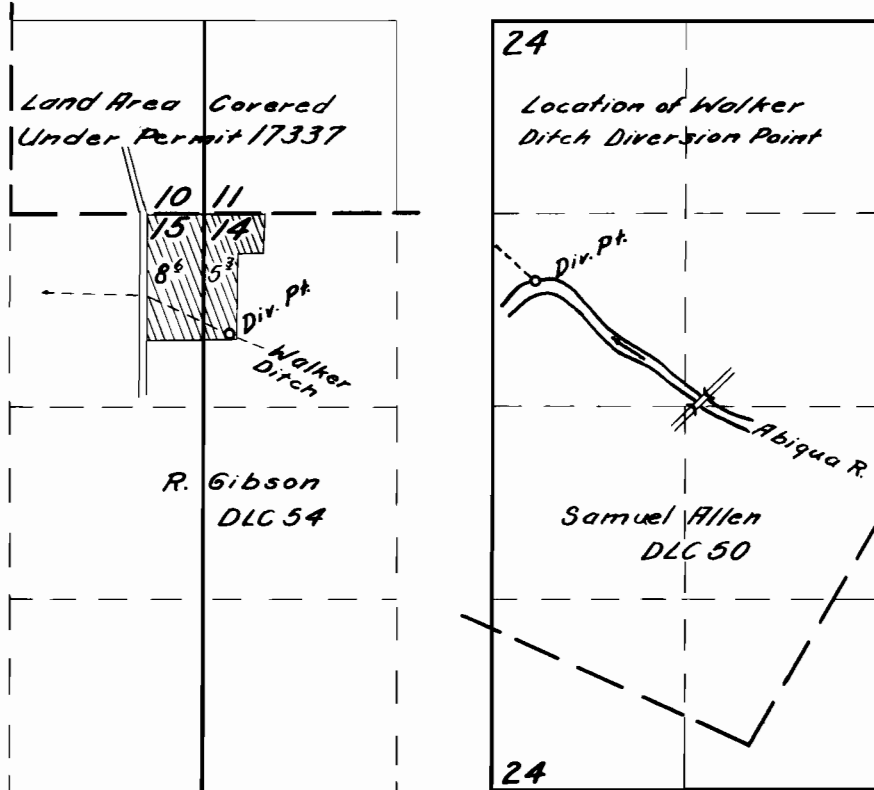

FINAL PROOF SURVEY

UNDER

Application No. 21827... Permit No. 17337...

IN NAME OF

Estate of Vincent Grasjacques

Surveyed *May 23* 1956, by *C.O. Bartels*.