


T.2 S. R. 5 W.W.M.

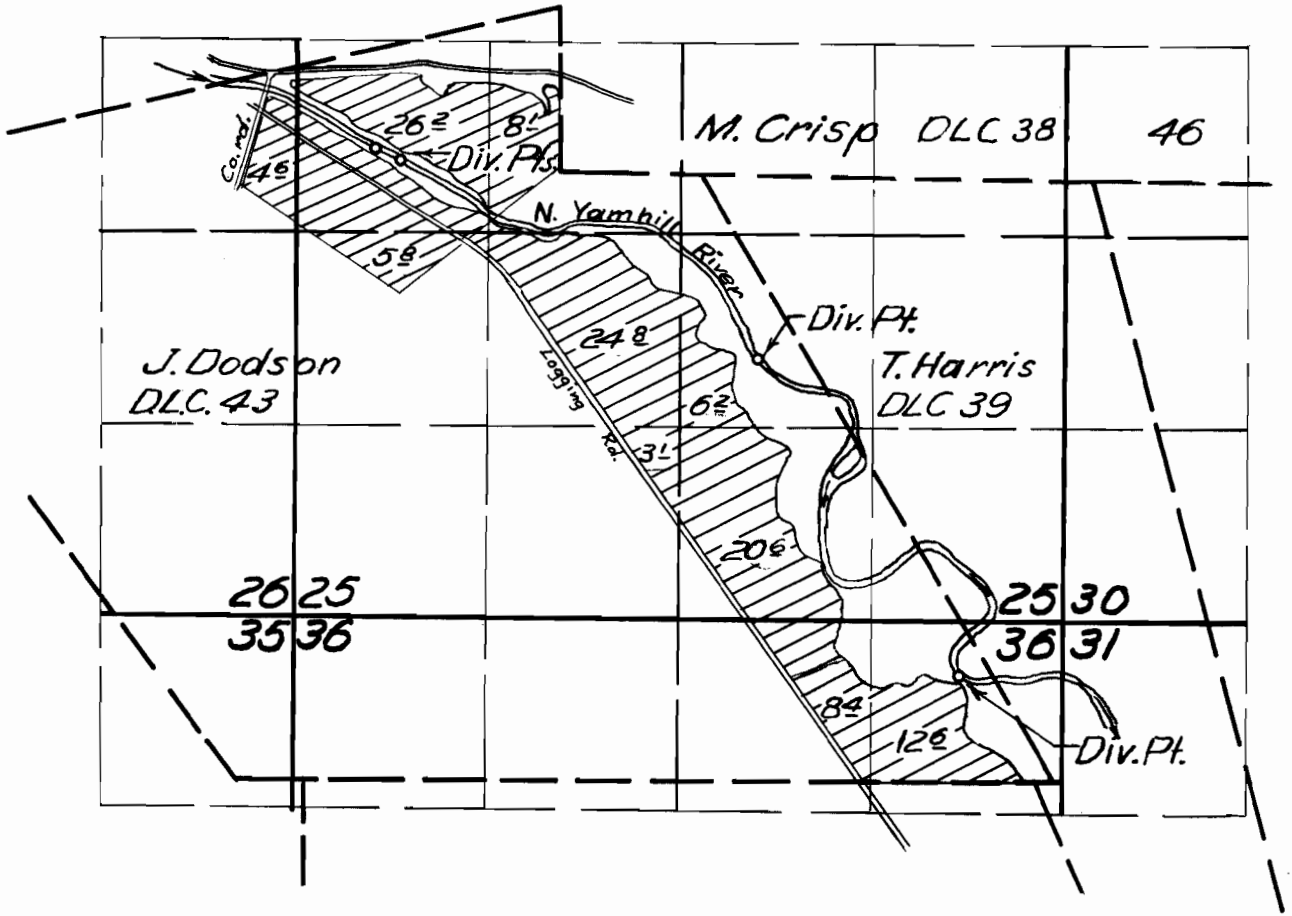

FINAL PROOF SURVEY

UNDER

Application No. 22396 Permit No. 17704

IN NAME OF

Harley S. Belt

Surveyed 4 April 1956, by Tom Bish