


T. 3S. R. 4E. WM.

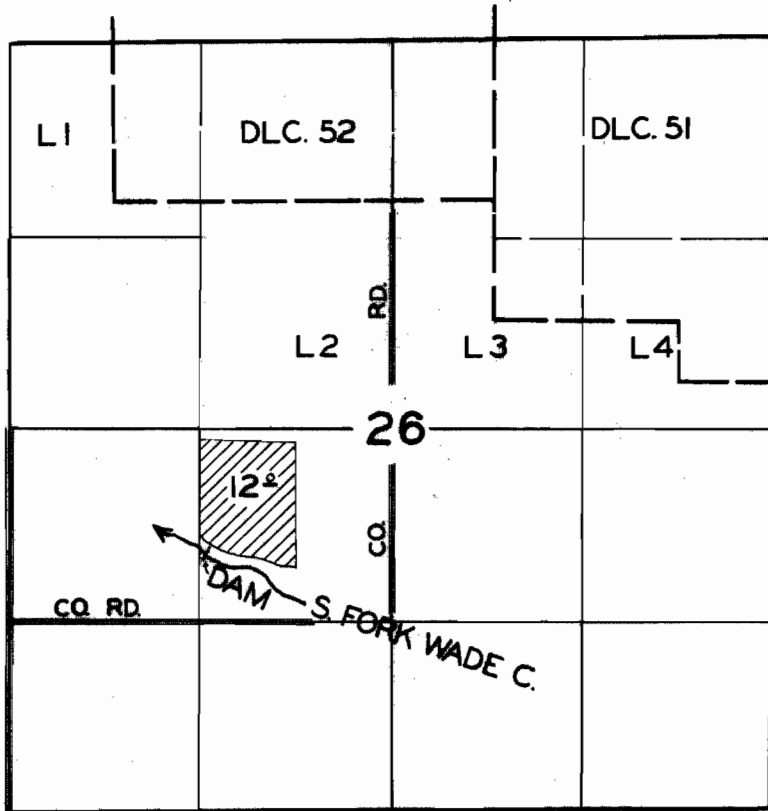

FINAL PROOF SURVEY

UNDER

Application No. 22596 Permit No. 17781

IN NAME OF

DR. FRED M. PICKERING

Surveyed 5 APR. 1956, by R.D. BEST