


T. 4 S. R. 3 W. W. M.

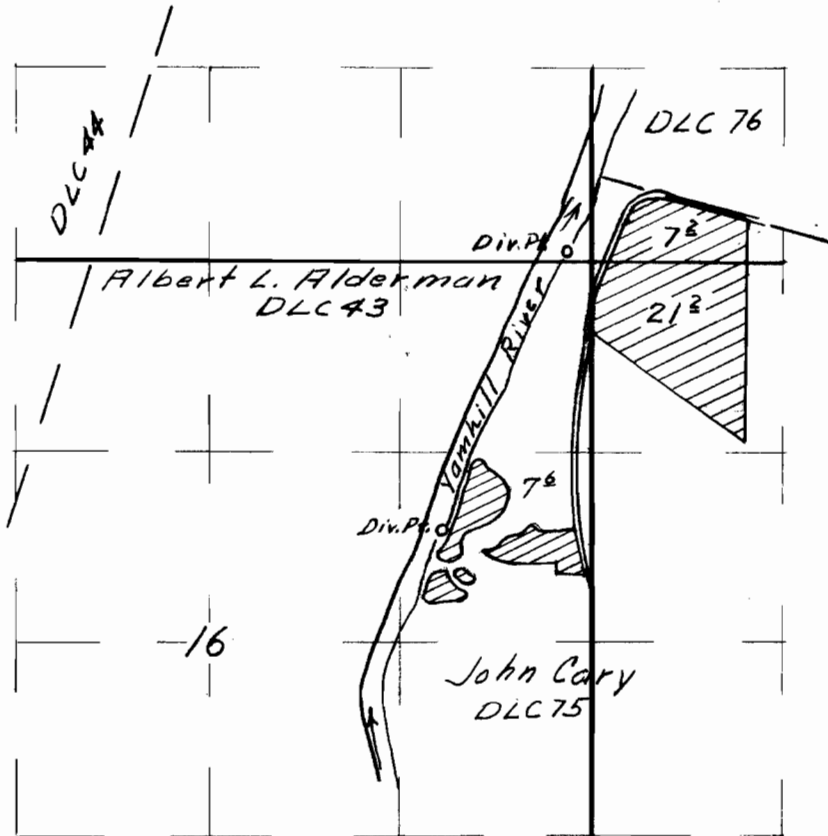

Final Proof Survey
Under

Application No. 22557 Permit No. 17970
In Name Of

Roy Albright

Surveyed June 6, 1955, by T. Jones