


T. 6S. R. 1E. W.M.

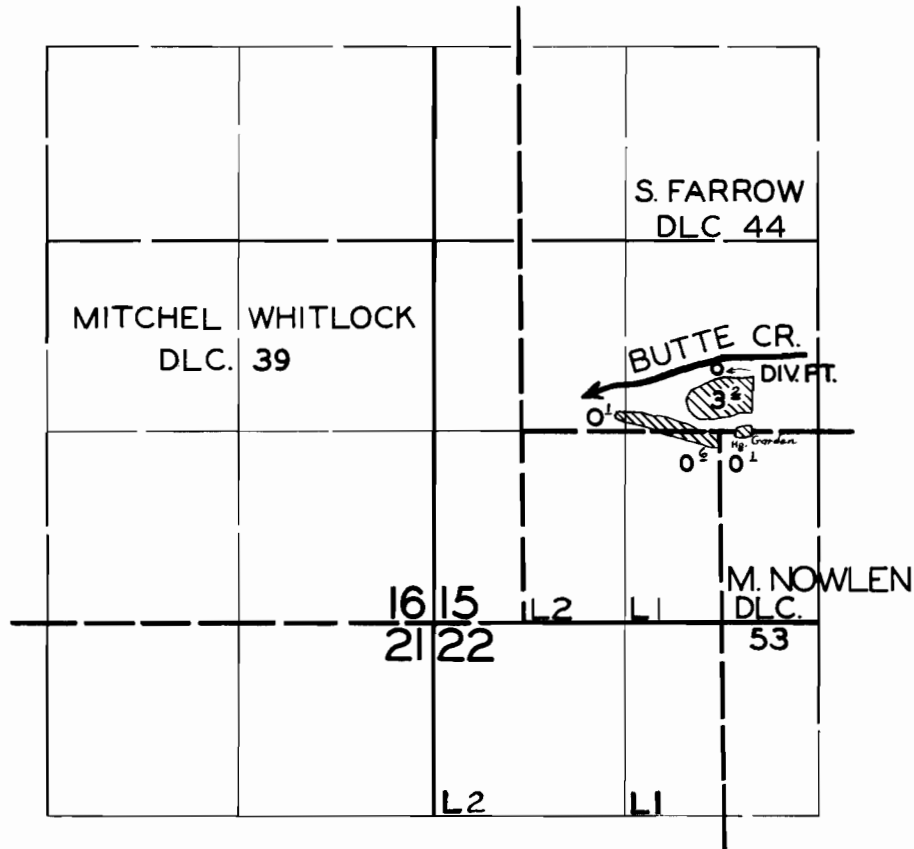

**FINAL PROOF SURVEY**  
UNDER

Application No. 23358 Permit No. 18450  
IN NAME OF

**ANTHONY BIELENBERG**

Surveyed 18 JULY 1956, by M. BISH