


T 4S. R. 1E. W.M.

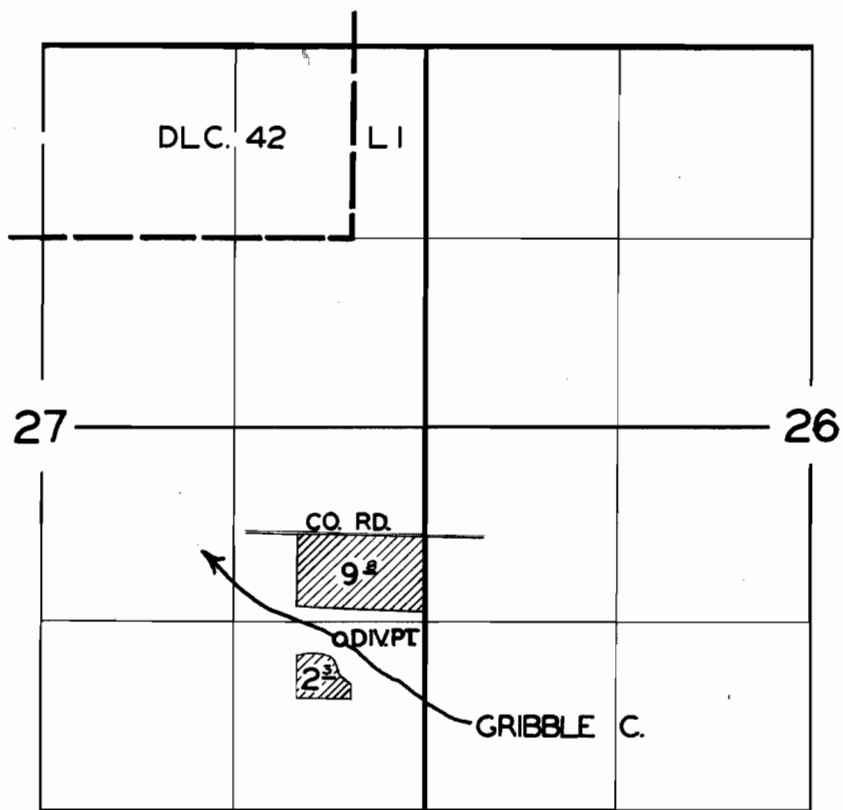

FINAL PROOF SURVEY

UNDER

Application No. 23395 Permit No. 18468

IN NAME OF

FRED HEINZ

Surveyed 9 MAR. 1956, by R.D. BEST

DFK-3D-85

R.D.B.