


T. 4S. R. 2E. W.M.

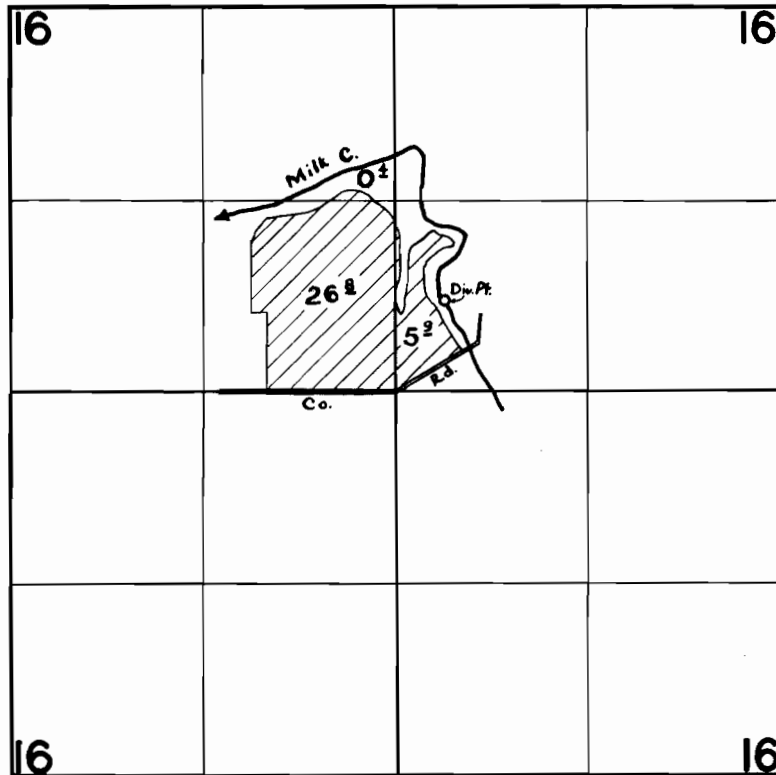

**FINAL PROOF SURVEY**

UNDER

Application No. 23619 Permit No. 18623

IN NAME OF

HENRY R. BRANDT

Surveyed 9 MAR. 1956, by R.D. BEST

100