


T. 2 S. R. 5 E. W. M.

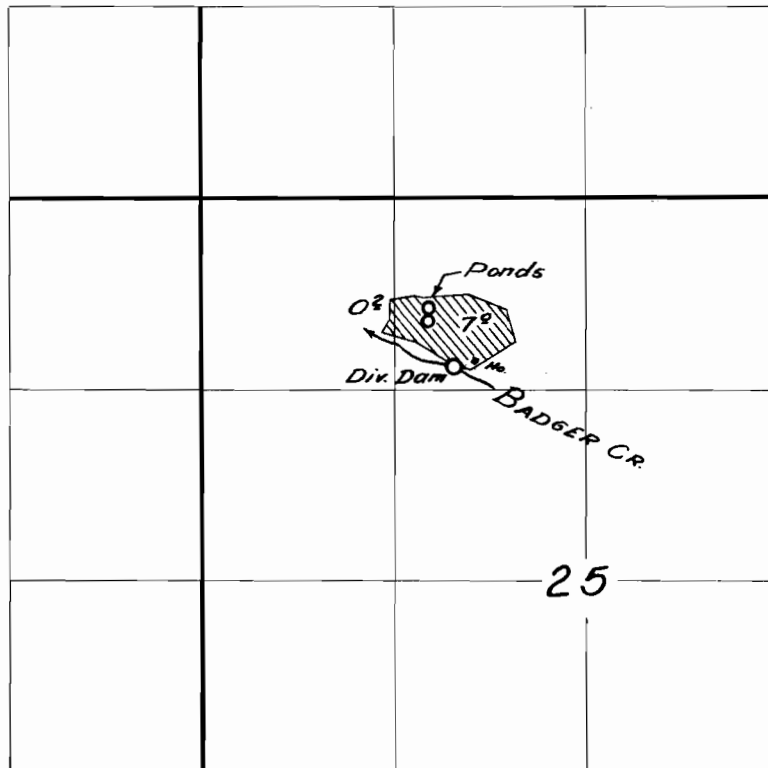

FINAL PROOF SURVEY
UNDER

Application No. 23746 Permit No. 18668
IN NAME OF

CURT WILHELM

Surveyed 24 June 1956 by A. H. Hitt