


T. 5S. R. 2E. W.M.

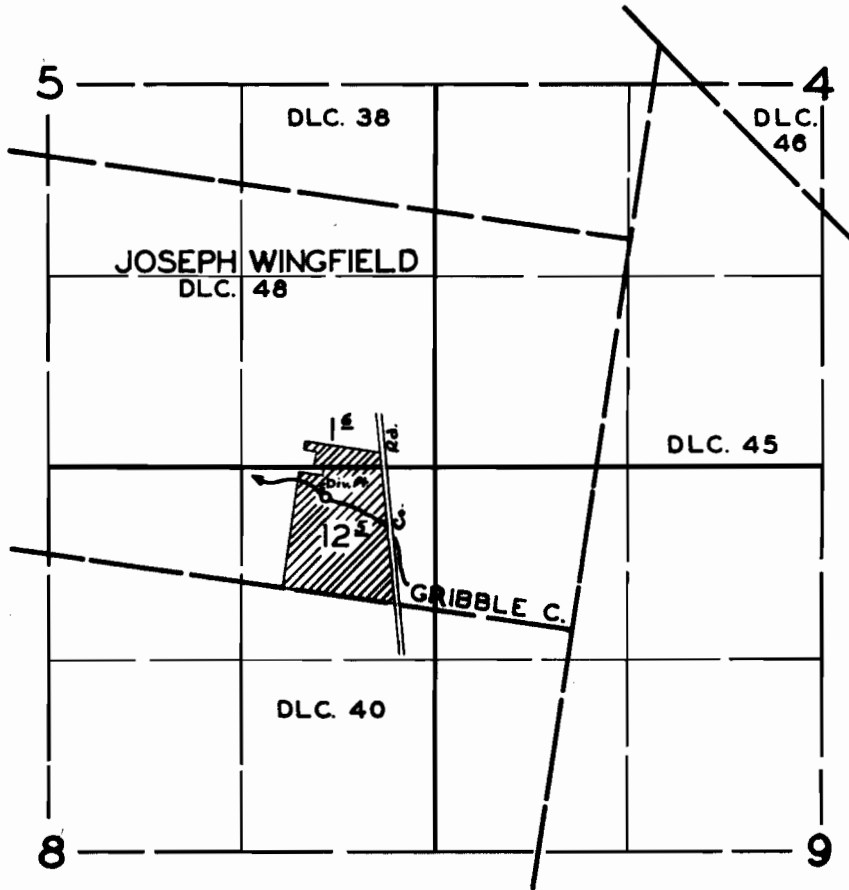

**FINAL PROOF SURVEY**  
UNDER

Application No. ~~23720~~ Permit No. ~~18732~~  
IN NAME OF

W. J. E. VICK

Surveyed 14 MAR. 1956. by R. D. BEST

205