


T. 1 S., R. 4 W., W.M.

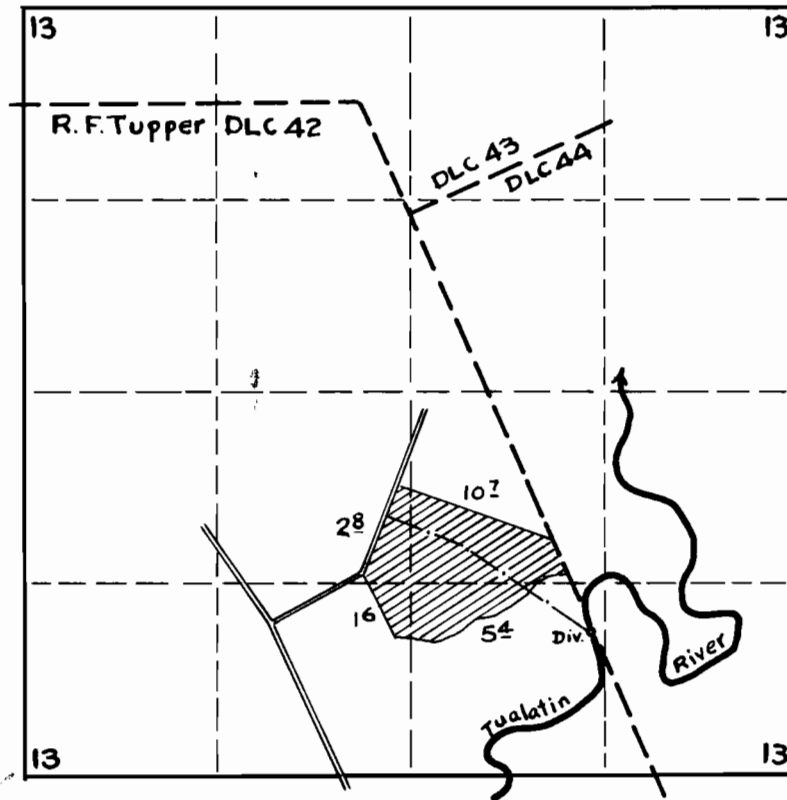

FINAL PROOF SURVEY
UNDER

Application No. 23775 Permit No. 18761....
IN NAME OF

Oakley E. Smith

Surveyed 4-23 1956, by R.D. Best