


T. 4 S. R. 1 W. W. M.

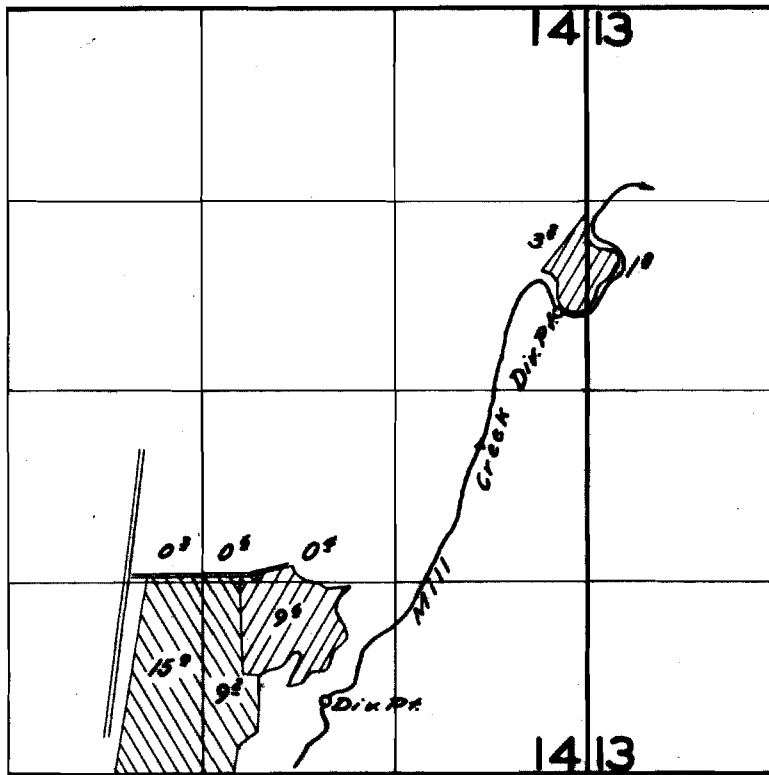

FINAL PROOF SURVEY

UNDER

Application No. ²⁸⁹¹⁰ ~~24135~~ Permit No. ²²⁷⁵⁸ ~~18998~~ 

IN NAME OF

..... *Walter P. Koenig*

Surveyed *June 22* 1956, by *C. O. Bartels*