


T. 4 N. R. 2 W. W. M.

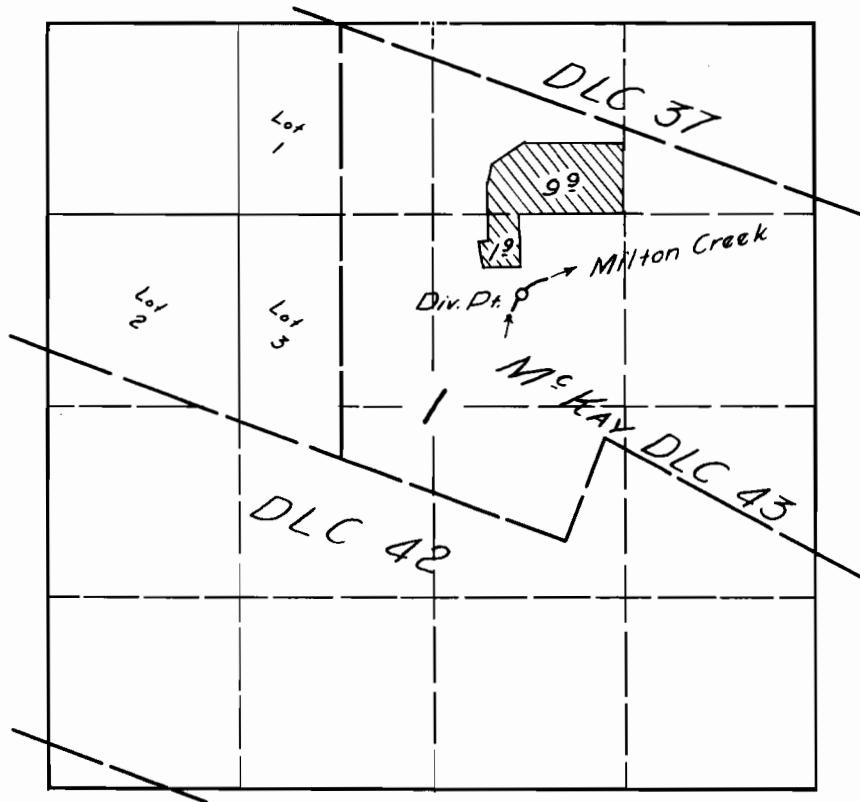

**FINAL PROOF SURVEY**

UNDER

Application No. 24317 Permit No. 19061

IN NAME OF

ERNEST M. HARRIS

Surveyed 13 July 1956, by [Signature]