


T.6S. R.1W.W.M.

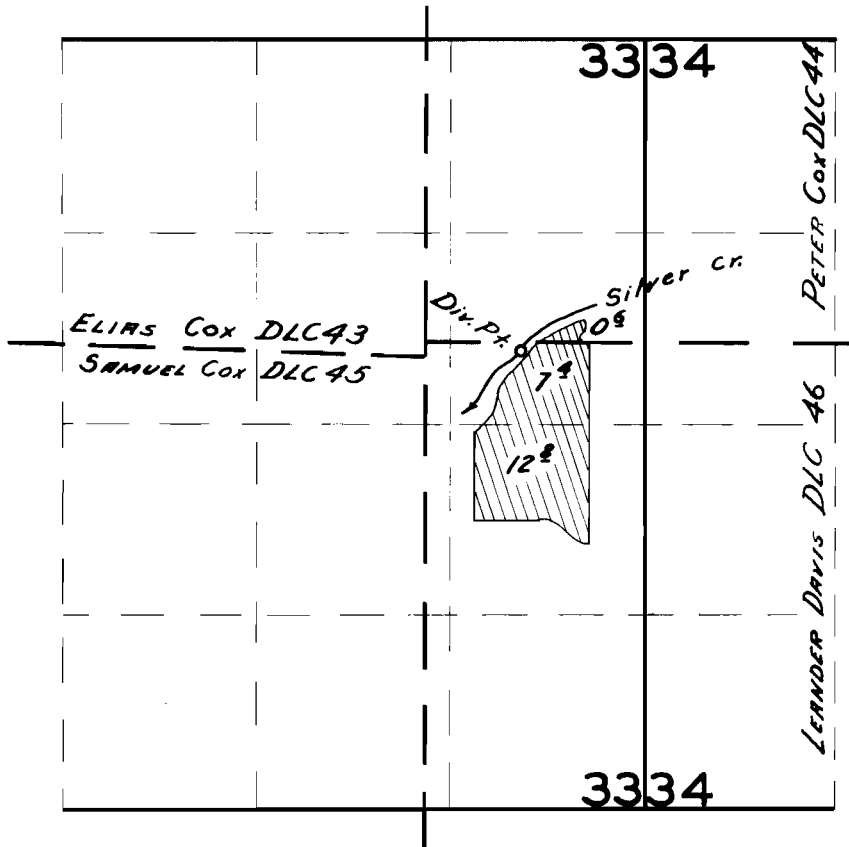

FINAL PROOF SURVEY

UNDER

Application No. 24055 Permit No. 19102

IN NAME OF

HUBERT ESSER

Surveyed May 24 1956, by C.O. Bartels