


T. 4 N R. 5 W W.M.

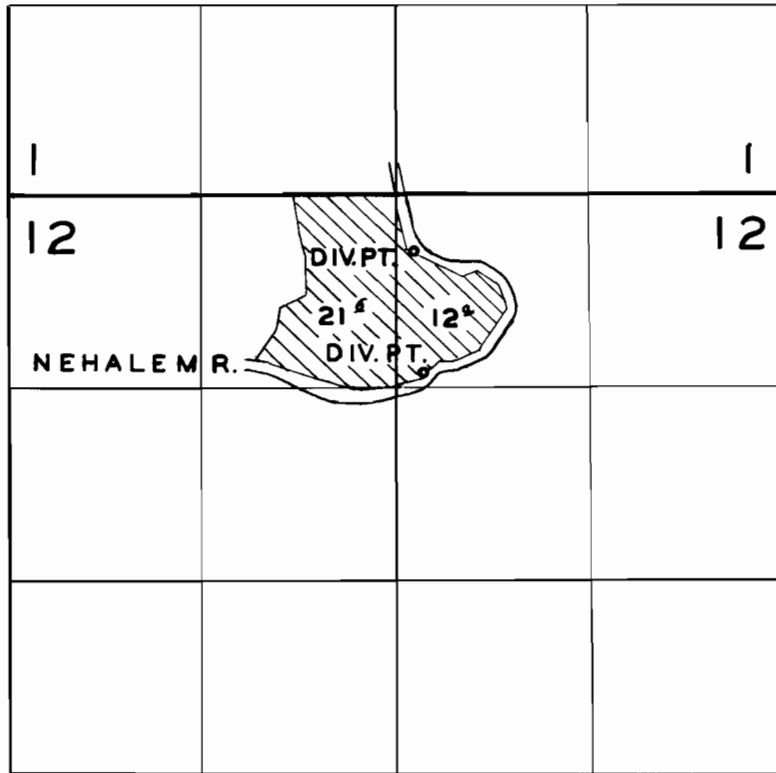

FINAL PROOF SURVEY

UNDER

Application No. 24115 Permit No. 19108

IN NAME OF

A. J. AND GERTRUDE KIRK

Surveyed SEPT. 12 1956, by R. H. WHITBY