


T. 4 S. R. 5 W. W. M.

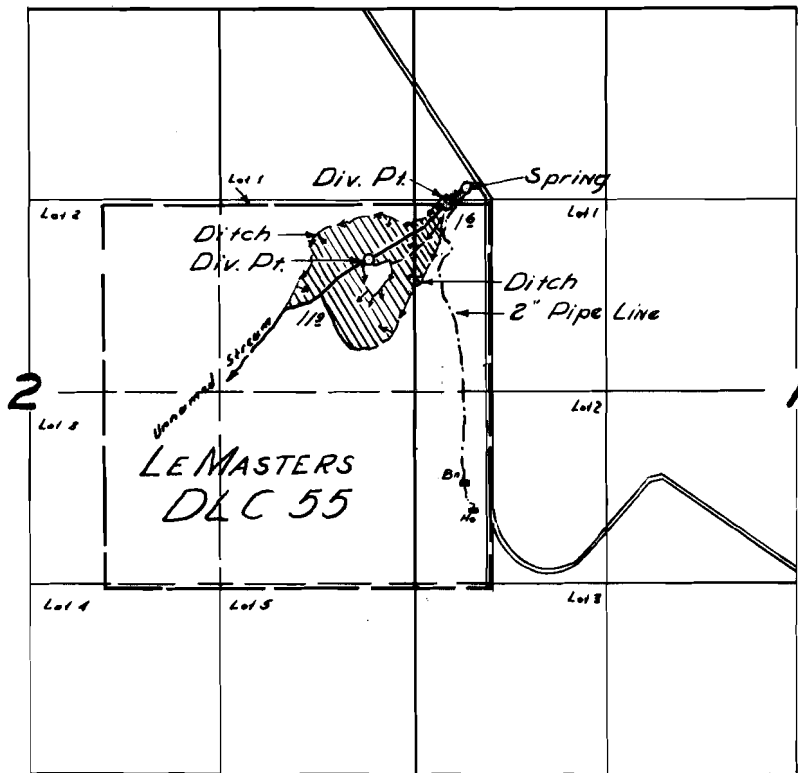

FINAL PROOF SURVEY
UNDER

Application No. 24117 Permit No. 19109
IN NAME OF

LAURENCE G. HUDSON

Surveyed 2 Apr. 1956, by *C. A. Whitley*