


T. 6 S. R. 1 W. W. M.

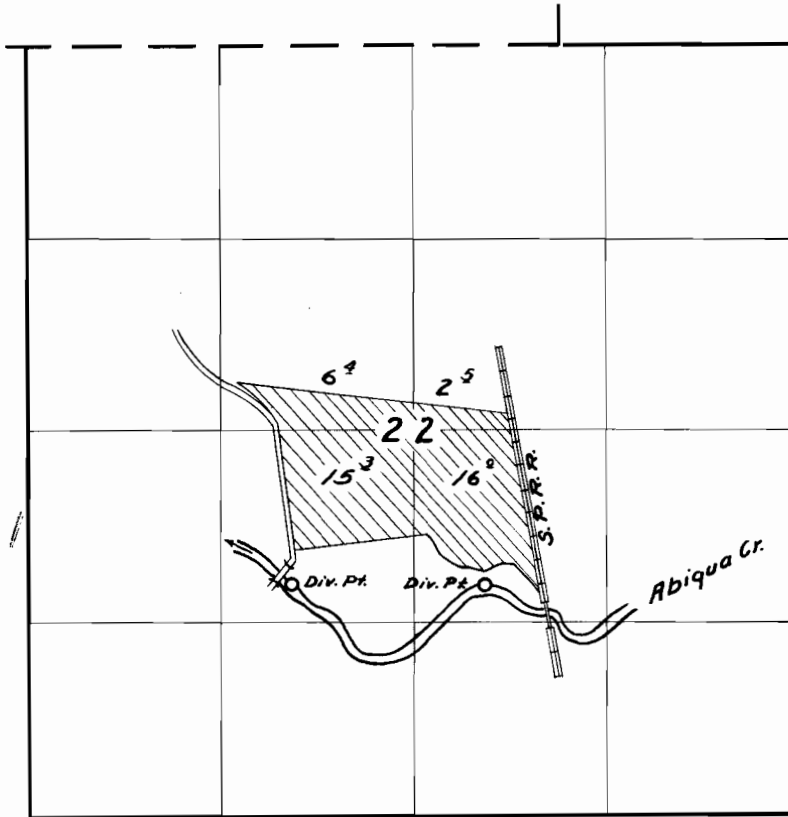

**FINAL PROOF SURVEY**

UNDER

Application No. ~~24338~~ Permit No. ~~19133~~

IN NAME OF

*Raymond Schiedler*

Surveyed *May 22 1956*, by *C.O. Bartels*