


T1N, R4W, WM

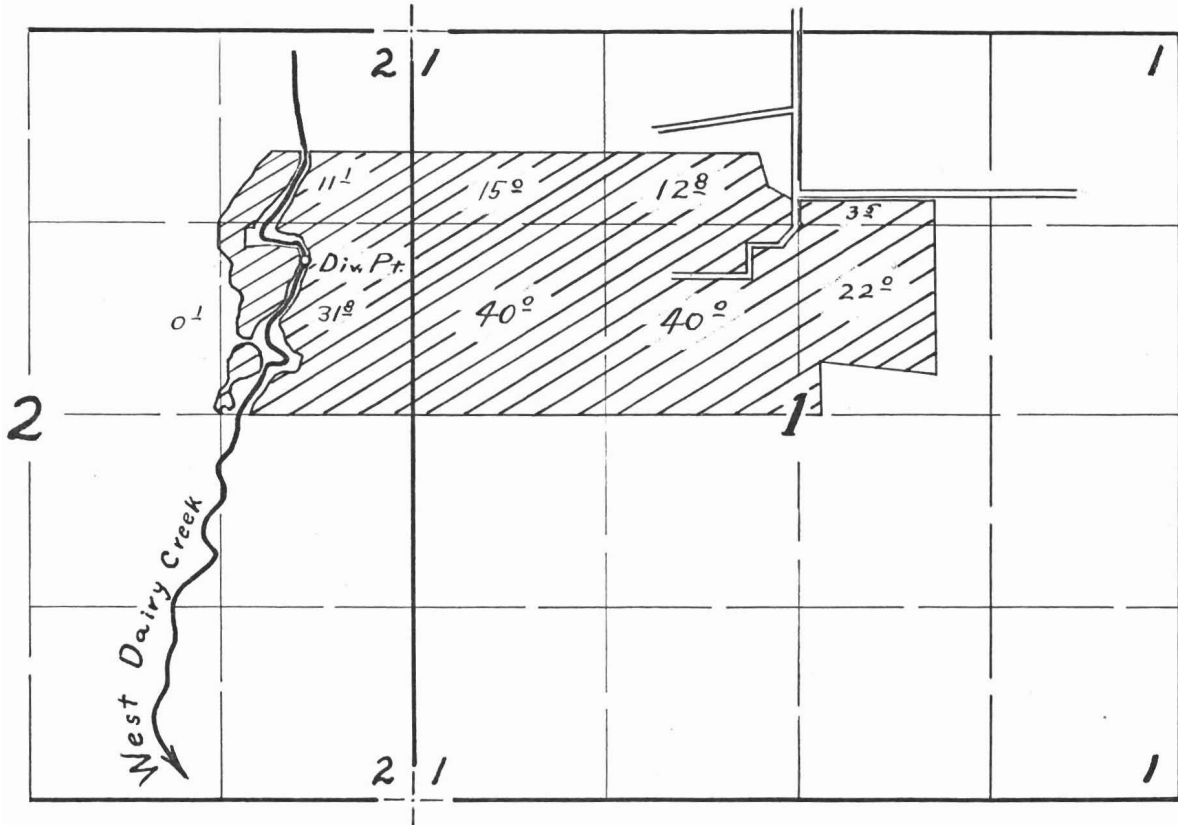

FINAL PROOF SURVEY

UNDER

Application No. 24367 Permit No. 19143

IN NAME OF

Ray Dierickx

Surveyed 4-9 1956, by R.D. Best