
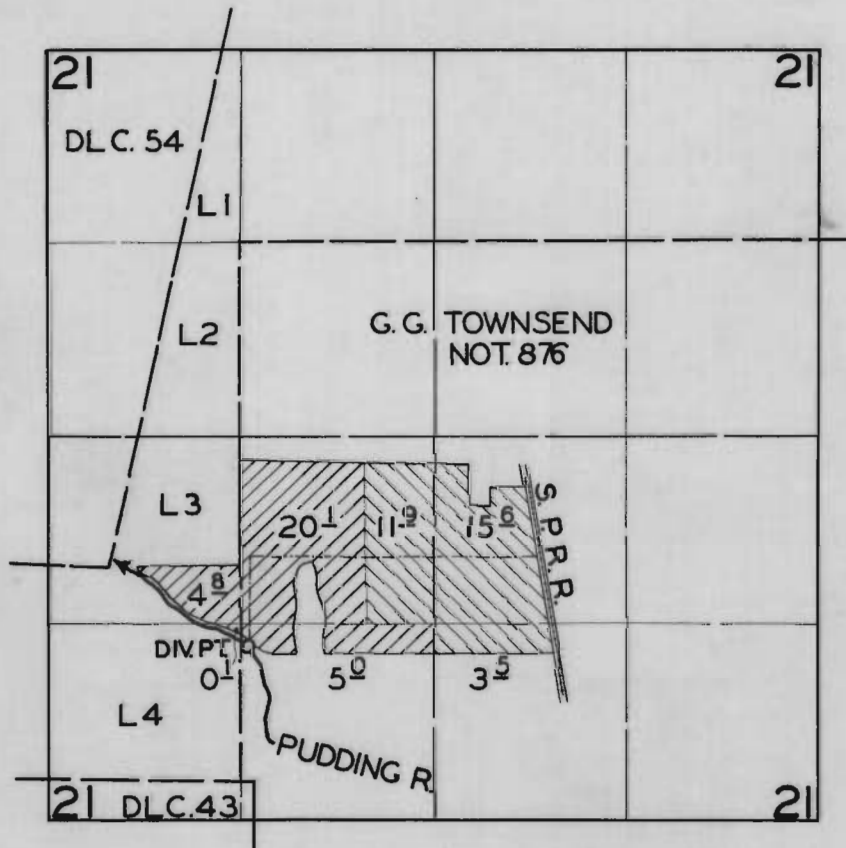


T. 5 S. R. 1 W. W. M.

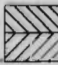

FINAL PROOF SURVEY

UNDER

Application No. **24202** Permit No. **19206** 
~~22122~~ ~~17428~~

IN NAME OF

P. H. SEELY

Surveyed 1 MAR. 1956, by R. D. BEST