


T 3S. R. 1E. W.M.

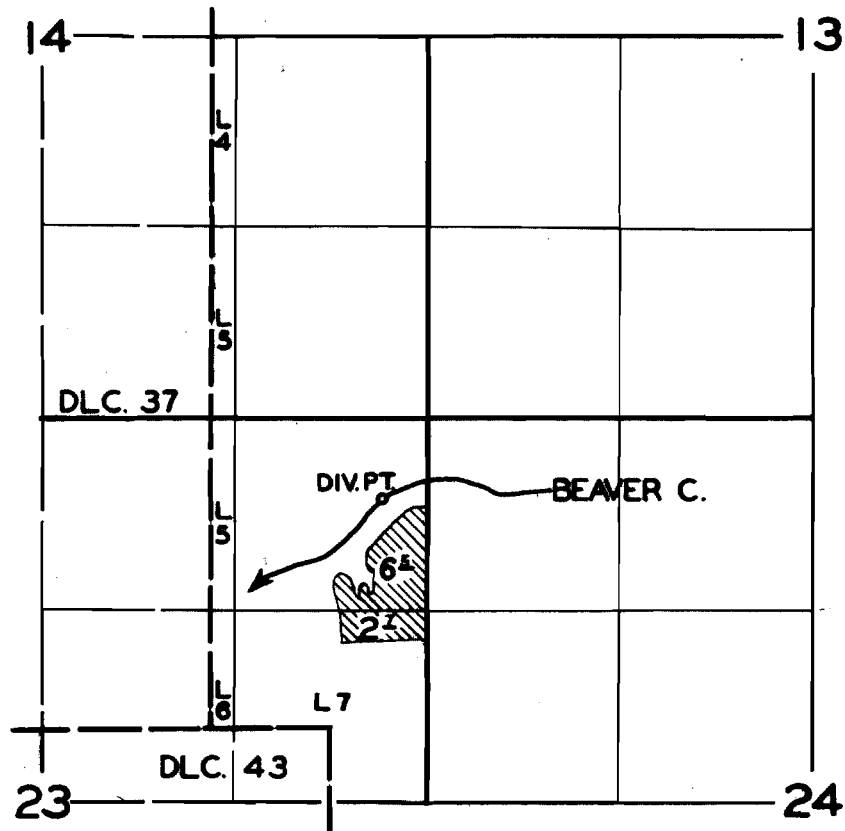

FINAL PROOF SURVEY
UNDER

Application No. 24274 Permit No. 19216
IN NAME OF

NORMAN J. & LAVERNE D. PANTENBURG

Surveyed 16 MAY 1956, by R. D. BEST