


T. 4 S. R. 3 - 4 W. M. M.

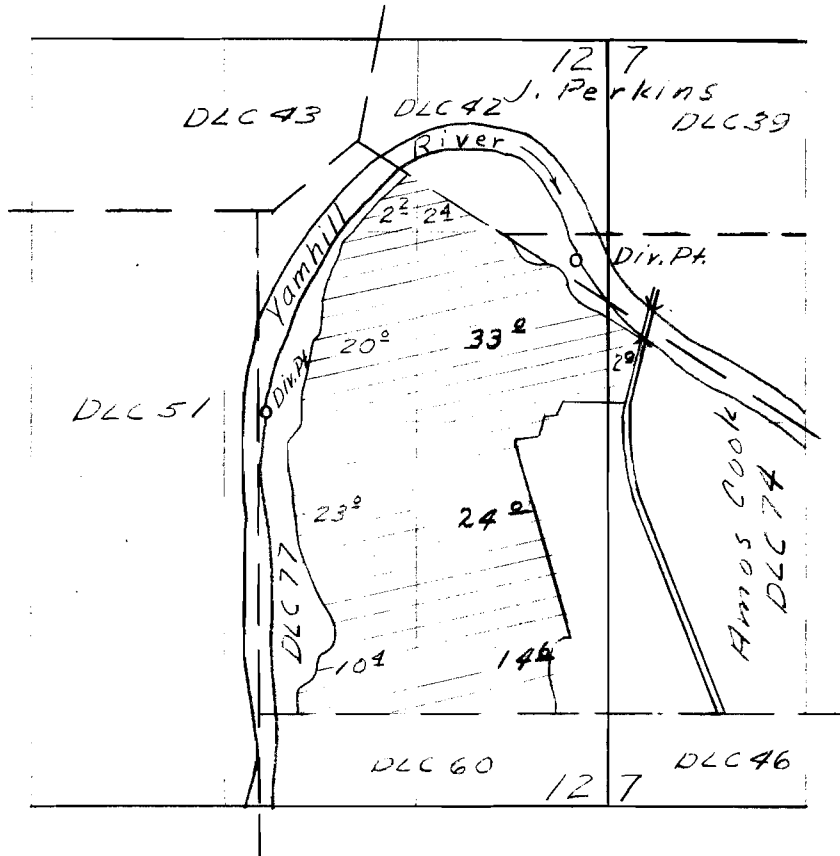

Final Proof Survey  
Under

Application No. 24398 Permit No. 19244  
In Name of

Stoller Bros.

Surveyed May 31 1955 by T. Jones