


T. 6 S. R. 1 W. W. M.

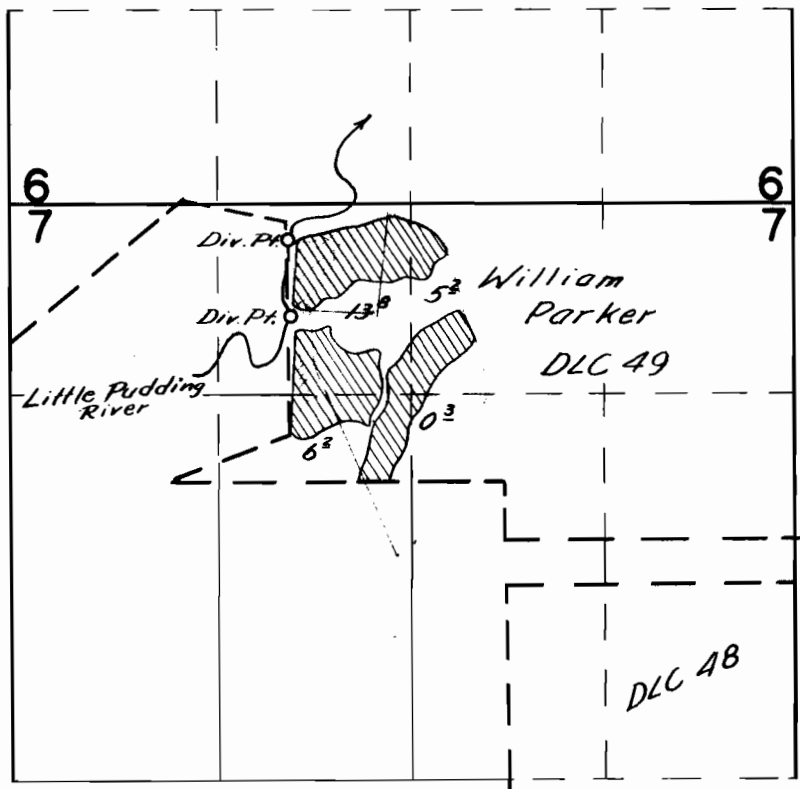

FINAL PROOF SURVEY

UNDER

Application No. *24439* Permit No. *19269*

IN NAME OF

Carlton J. McLeod

Surveyed *May 25* 1956, by *C. Q. Baultis*