


T. 5 S. R. 5 W. W.M.

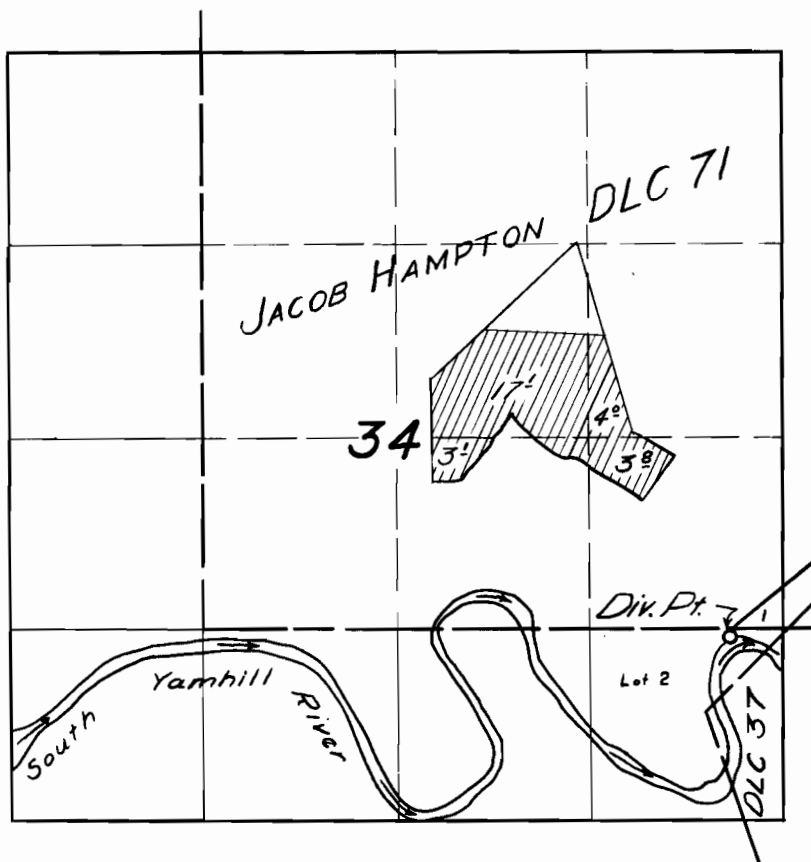

FINAL PROFESSIONAL SURVEY

UNDER

Application No. 24560 Permit No. 19363

IN NAME OF

HARRY F. CROWE

Surveyed 20 Mar 1956, by *C. D. Smith*