T. 3S., R. 1W. & 1E., W.M.

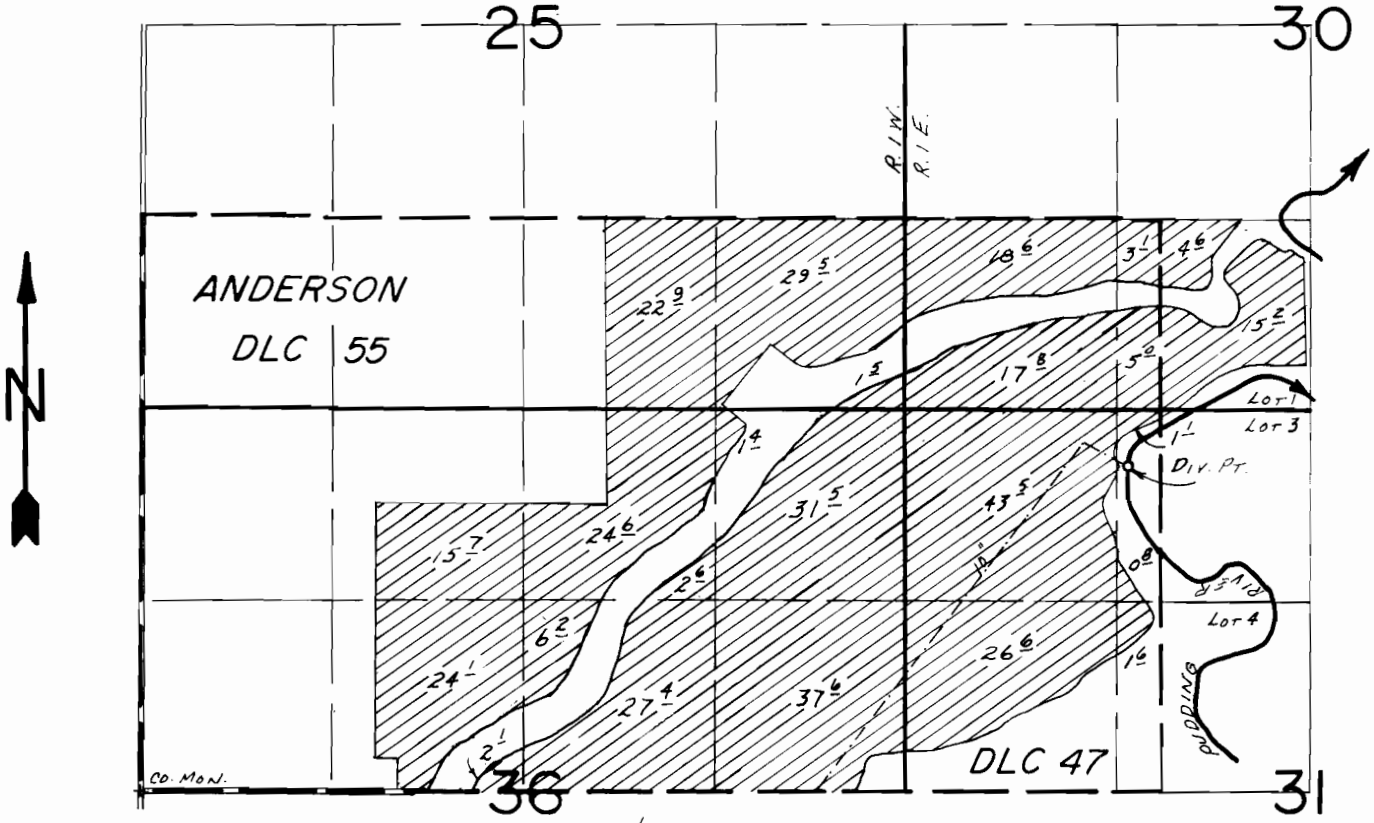

DIV. PT. LOC.: 1700'S. & 230'W. FROM NE COR. ANDERSON DLC 47

SCALE: 1" = 1320'

FINAL PROOF SURVEY

UNDER

Application No. 24626 Permit No. 19470

IN NAME OF

O. O. OGDEN

Surveyed May 16 19 56, by R. D. BEST

5-15-85

DFK-3D-16

HWB