


T.12S.R.28E.W.M.

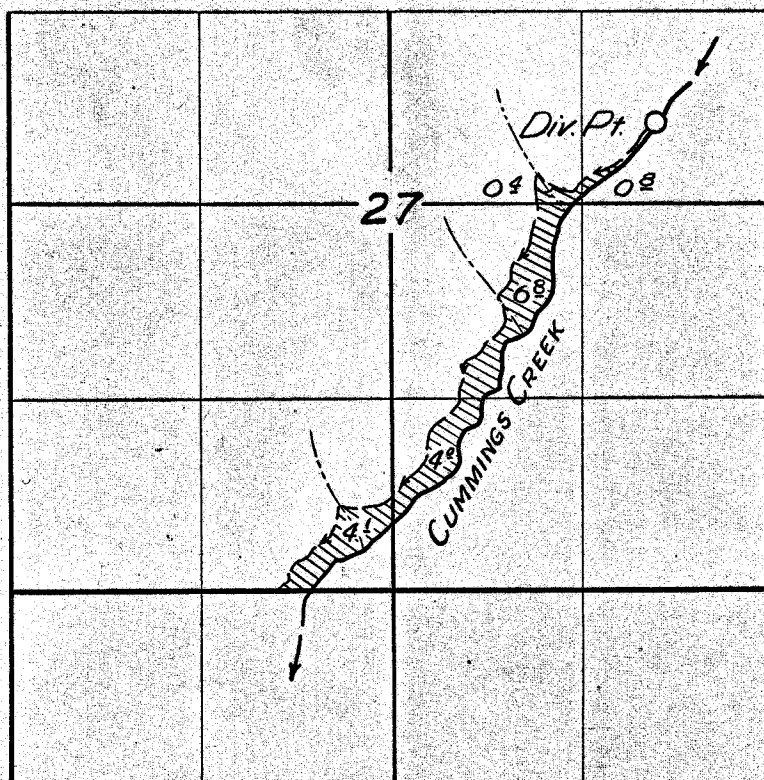

FINAL PROOF SURVEY
UNDER

Application No. 24787 Permit No. 19528
IN NAME OF

Kenneth L. Moore

Surveyed 27 Oct. 1955, by [Signature]

1955-F