


T.26S. R.2E.W.M.

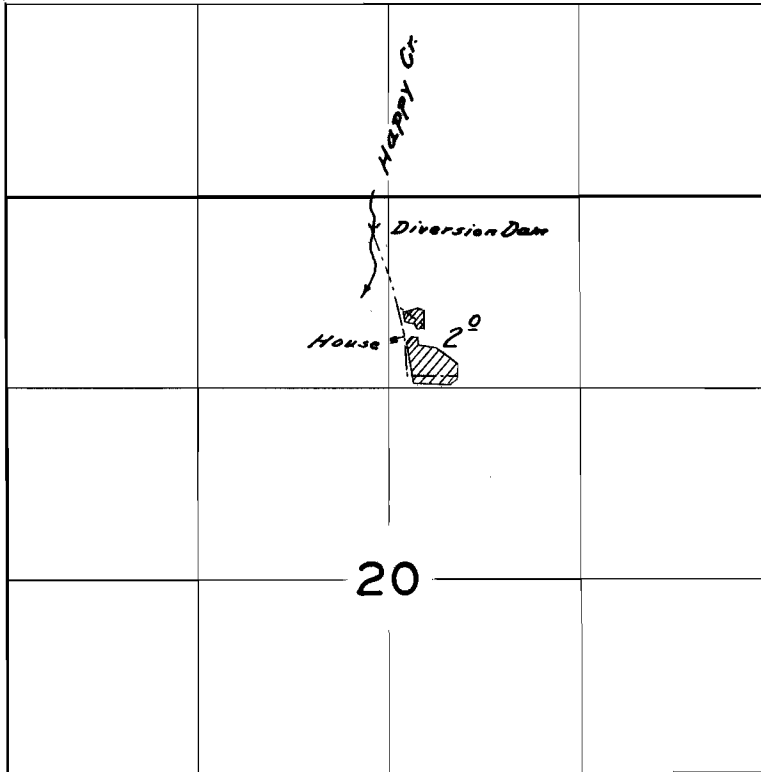

FINAL PROOF SURVEY

UNDER

Application No. 24951 Permit No. 19599
IN NAME OF

Perry J. Wright

Surveyed June 6 1956, by G.O. Bartels