


T. 5 S. R. 3 W. W.M.

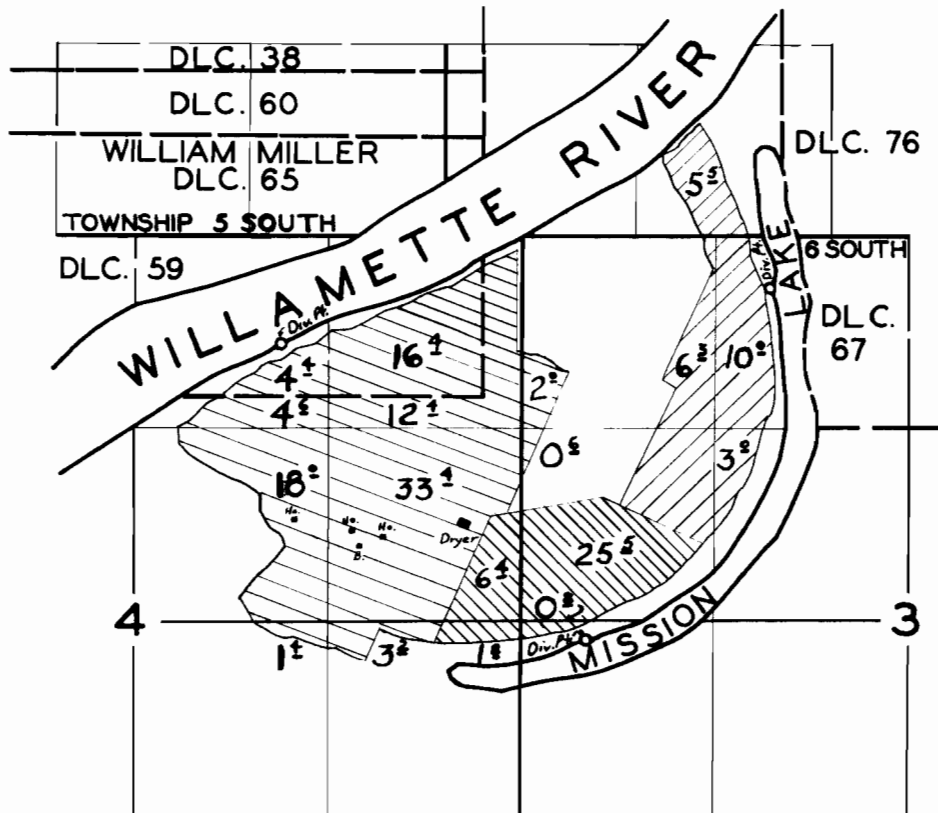

FINAL PROOF SURVEY

UNDER

Application No. 24889. Permit No. 19681...

IN NAME OF

NATIONAL HOSPITAL ASSO. - BEAVER ISLAND FRUIT ACRES

Surveyed 5 JULY 1956, by M. BISH.....