


T. 3 S. R. 3 W. W.M.

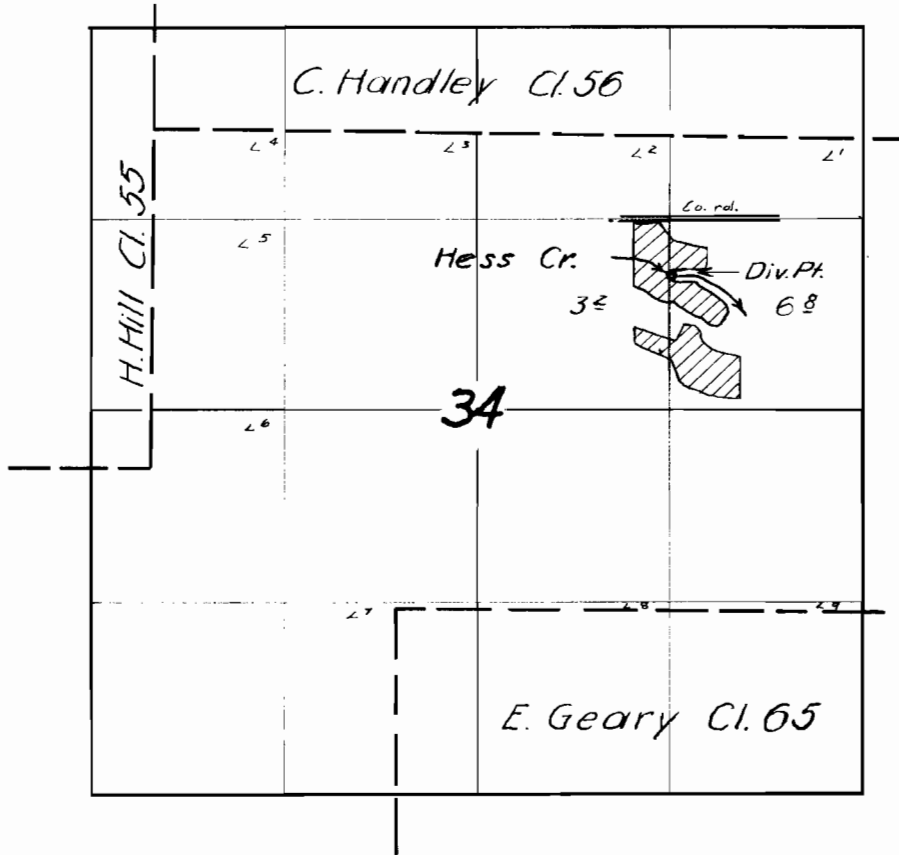

FINAL PROOF SURVEY

UNDER

Application No. 25023 Permit No. 19715

IN NAME OF

Philip G. Wilson

Surveyed Mar 29 1956, by Tr. Bish