


T.4 S. R. 5 W. W.M.

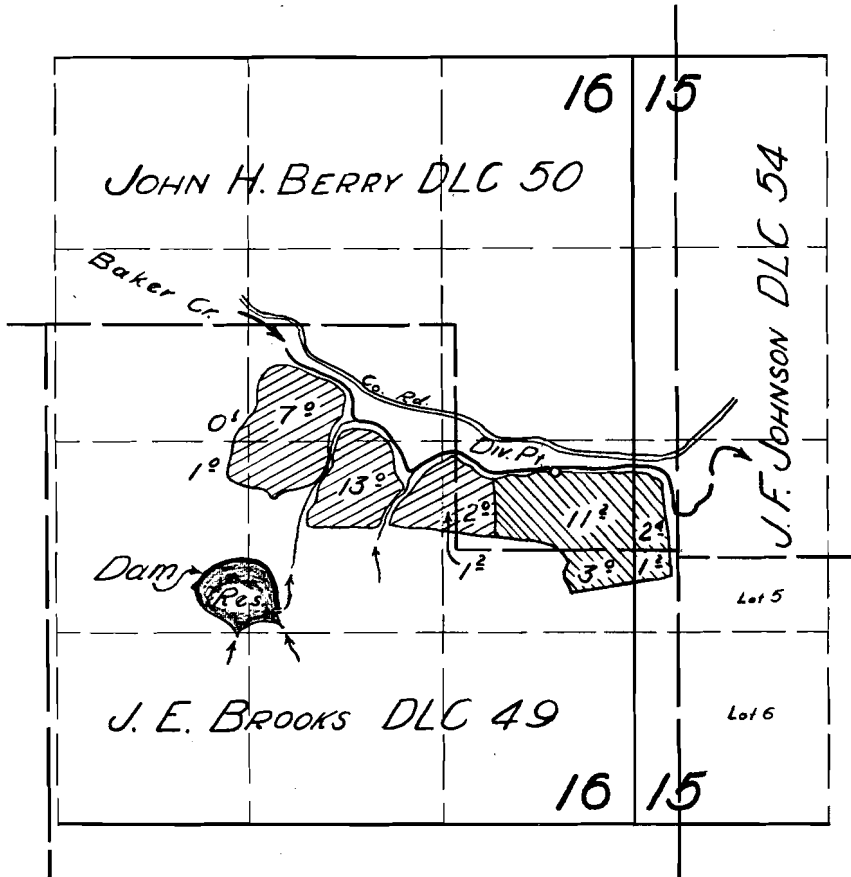

FINAL PROOF SURVEY

25085

19746

R-27295

R-1411

Application No. 27296 Permit No. 21669

IN NAME OF

D. MOCHETTAZ

Surveyed 19 Mar 1956, by

*C. H. White*