



[illegible]

Township 4 S

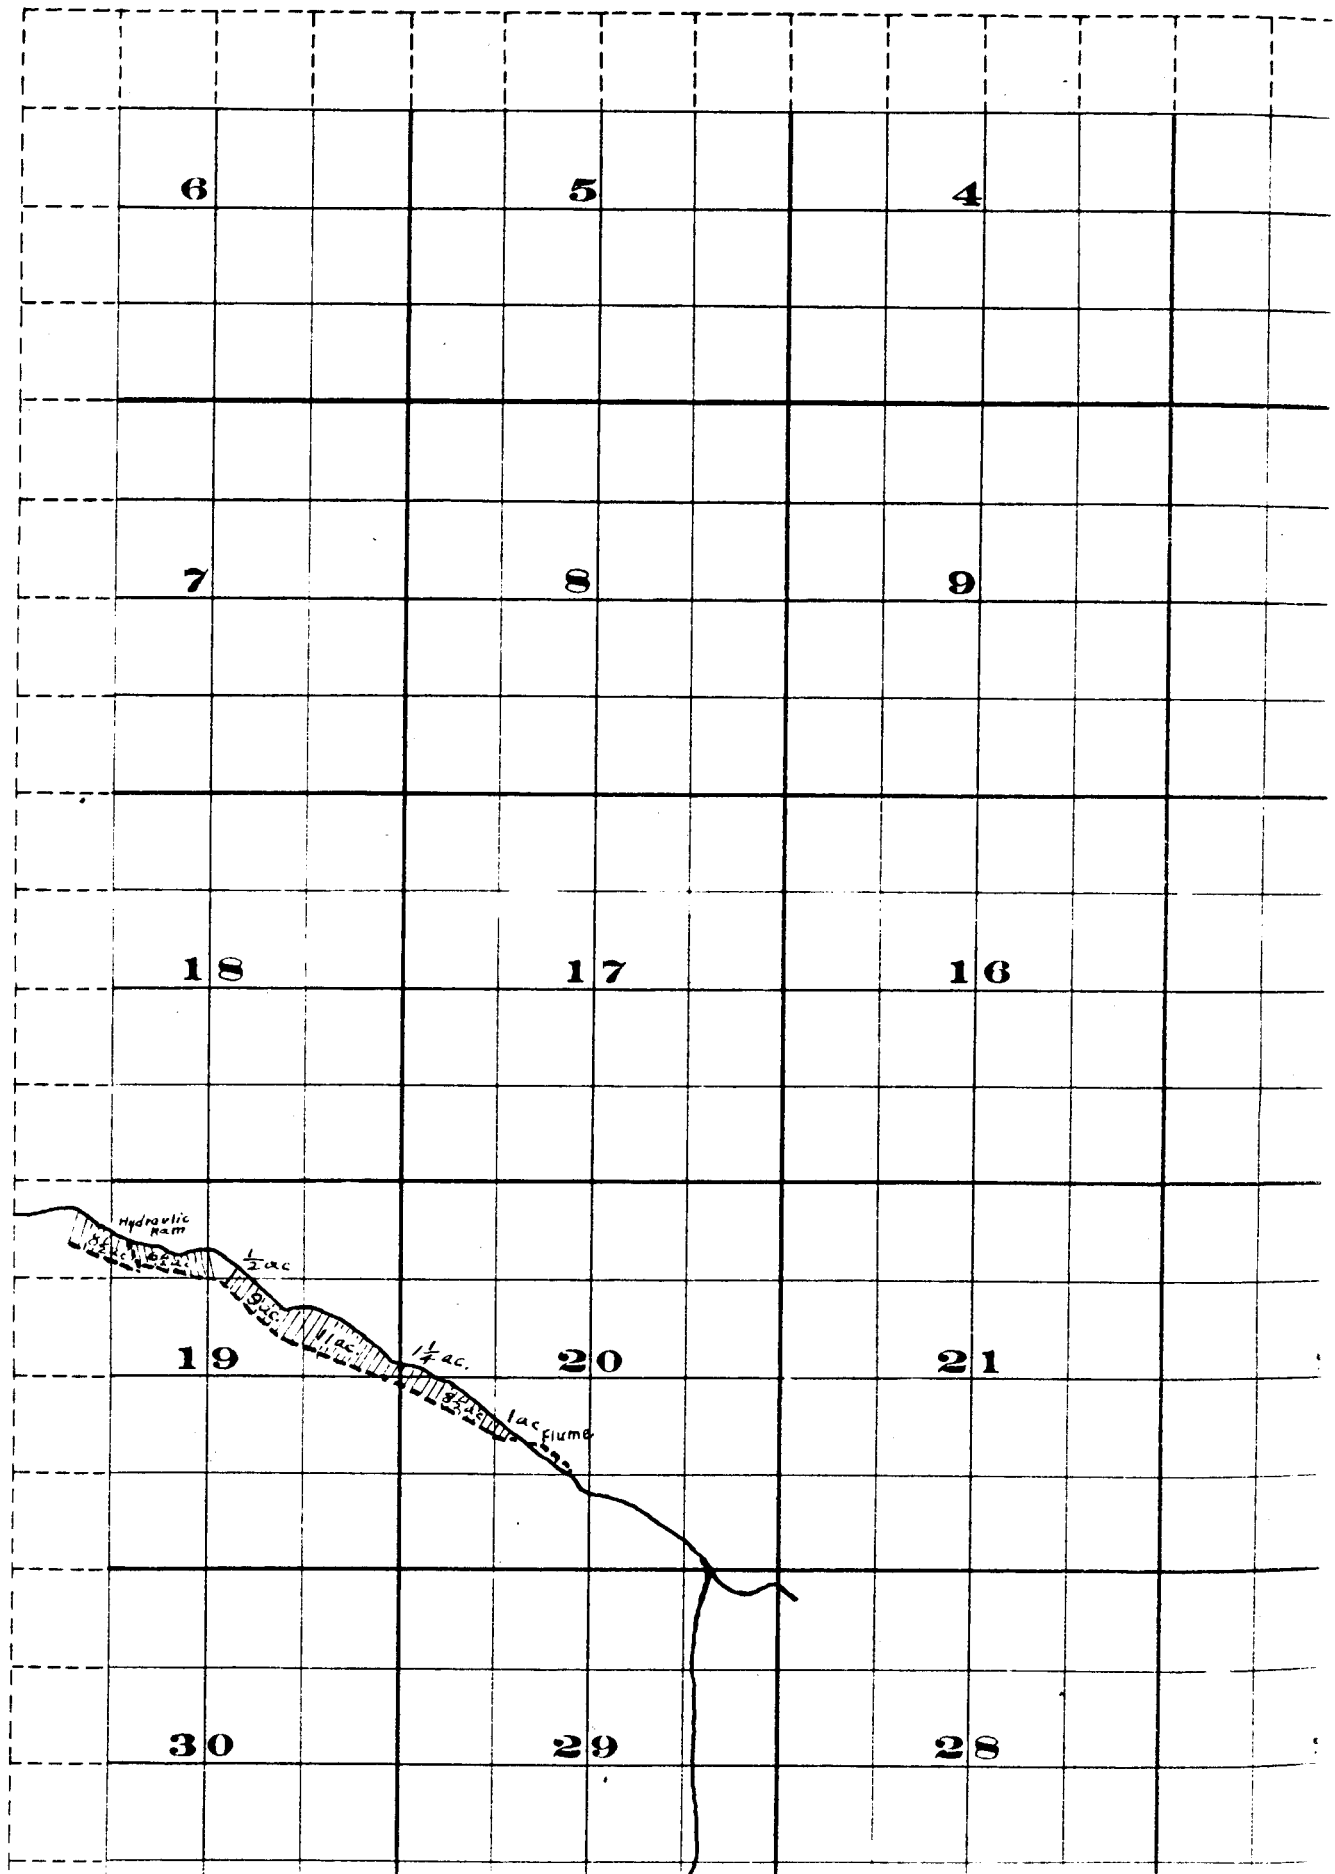

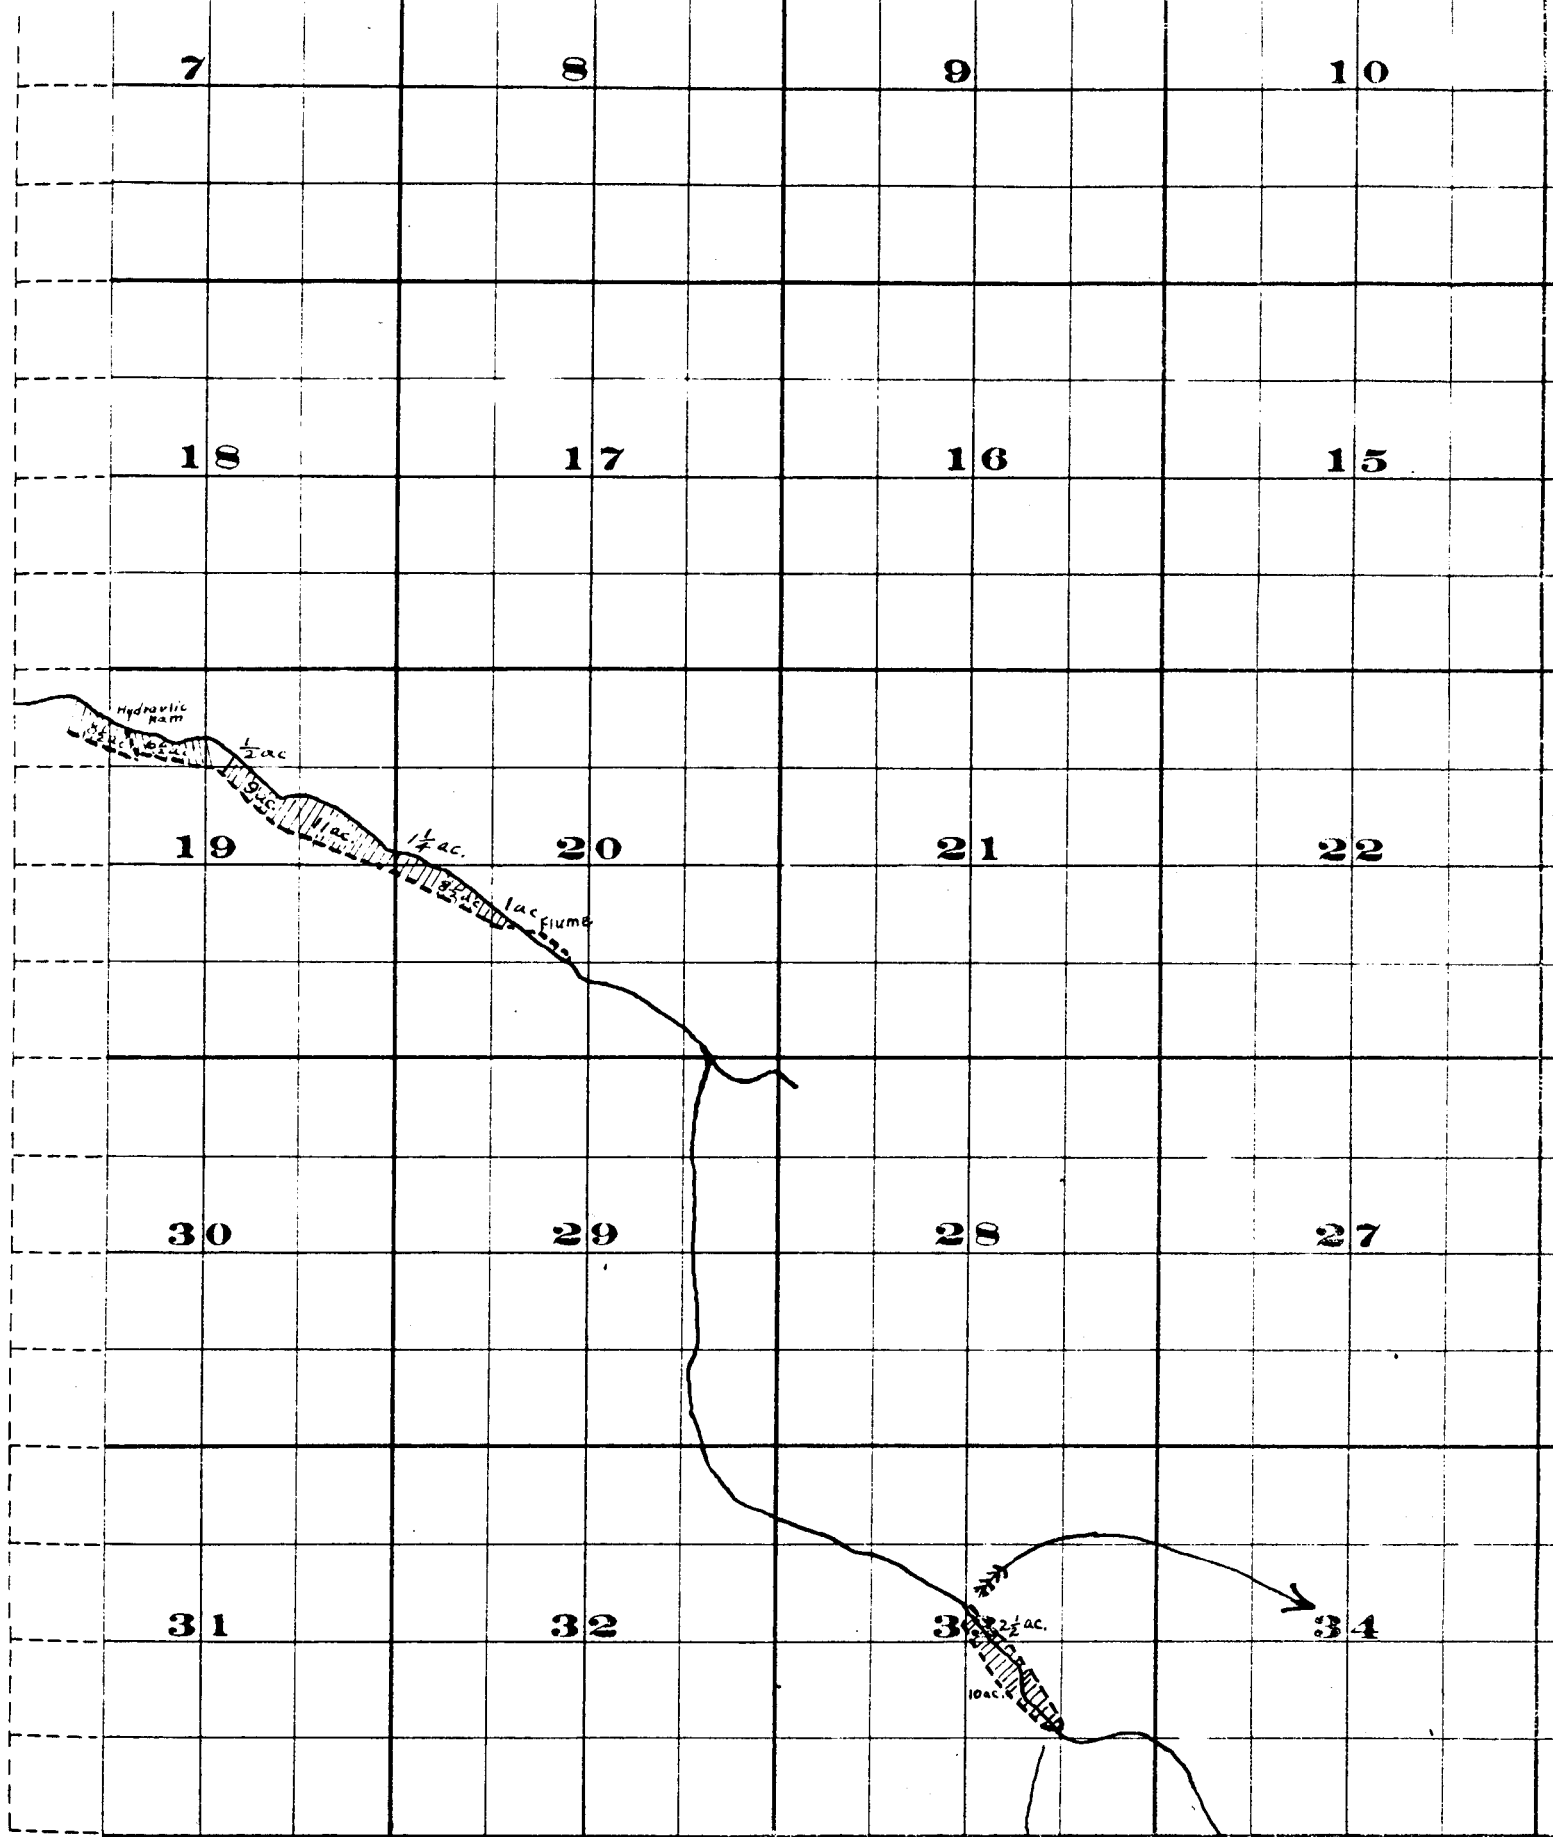


THE S. B. STOL CO., PRINTERS & BOUND BOOKS, NEW YORK, N.Y.

Surveyed by H. K. Donnelly July 1909

John H. Lewis - State Engineer.

Examined July 14, 1909.

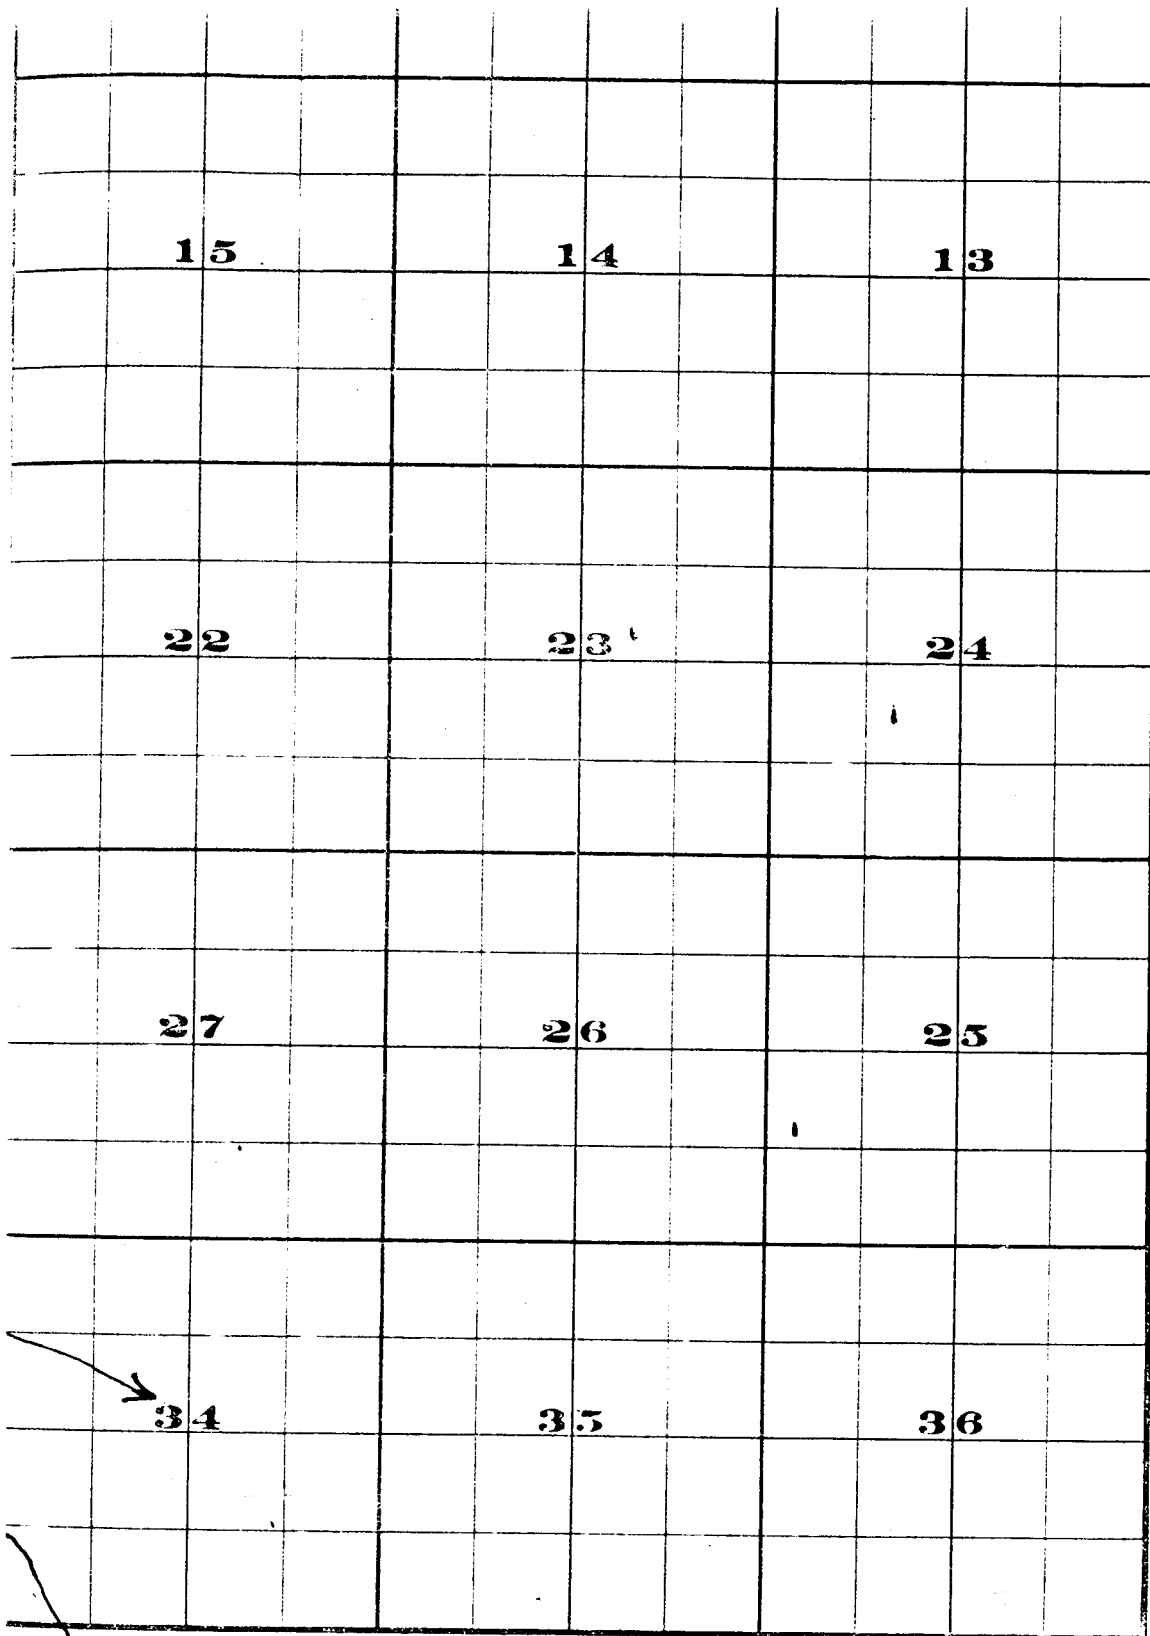

or- should be in sec. 34

FROM OFFICE OF THE STATE ENGINEER, SALEM, OREGON

Willow Creek Adjudication

4 S. 27 E