


T. 6 S. R. 2 E. W. M.

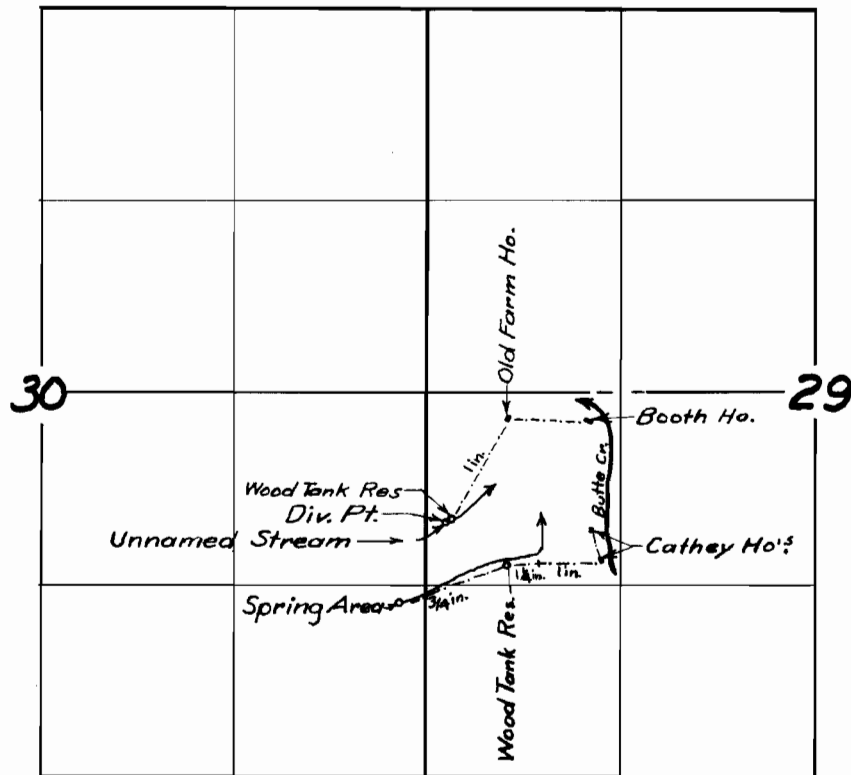

FINAL PROOF SURVEY

UNDER

Application No. 25272. Permit No. 19968.

IN NAME OF

Collie F. Cathey

Surveyed 9 Aug. 1956 by M. Bish.